

CORNER REPORT FORM

Section B Township 255 Range 3W  
Douglas County Date 3-207

CORNER DESIGNATION

C/W 1/16  
C/4 & SE 1/16

Previous Renewals/Surveys, etc:

M 136-33

Monument(s) & Accessories Found: (Condition and Source)

Fd monuments & RT'S  
Per M136-33

Condition Report only

- Not Found
- Renewed
- Unrecorded
- Surveyed In
- Referenced out

FILED

Date: 3-12-2007 By: X

This survey consists of:

Map: \_\_\_\_\_

Narrative: \_\_\_\_\_

Corner Rpt: 65/60-14

DOUGLAS COUNTY  
SURVEYOR

Monument Detail

Sketch

Monument Set (Procedures and Description)

New Accessories

Location & Comments

Surveyor's Seal

Compass Declination



Firm/Agency: i.e. Engineering, Inc.

Address: 505 SE Main  
Roseburg, OR 97470

Party Chief: Mike Fromdahl

Notes:

Witness: Bill Goodson

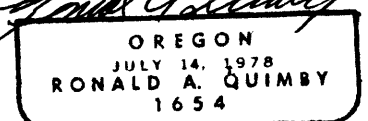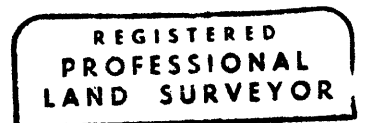

12-31-08

C.S. File No 65/60-14