

CORNER REPORT FORM

Section 8 Township 255 Range 3W
Douglas County Date 3-2-07

CORNER DESIGNATION

CS 1/16

Condition Report only
Not Found
Renewed
Unrecorded
Surveyed In
Referenced out

Previous Renewals/Surveys, etc:

M 136-33

Monument(s) & Accessories Found: (Condition and Source)

Fd Alum CAP per M 136-33
14" fir S 58°E 17 1/2 feet GOOD SCAR
DOWN 12" Hemlock

Monument Detail

Sketch

Monument Set (Procedures and Description)

FILED

Date: 3/12/2007 By: JC
This survey consists of:
Map: _____
Narrative: _____
Corner Rpt: 65/60-15

DOUGLAS COUNTY
SURVEYOR

New Accessories

scribed New RT
24" Cedar N 41°E 10 1/2 FT
scribed CS 1/16 SB RT

Location & Comments

Approx 40' EAST
OF ROAD

Surveyor's Seal

Compass Declination



Firm/Agency: i.e. Engineering, Inc.

Address: 505 SE Main
Roseburg, OR 97470

Party Chief: Mike Fromdahl Ronald A. Quimby

Notes:

Witness: Bill Goodson

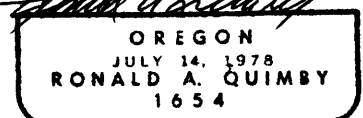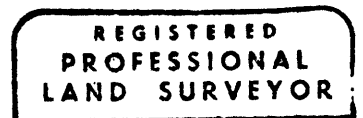

EXP 12-31-08

C.S. File No 65/60-15