

FILED

Date: 4-3-07 By: JC

This survey consists of:

Map: _____

Narrative: _____

Corner Ept: 65/60-16

DOUGLAS COUNTY
SURVEYOR

OREGON CORNER RESTORATION FORM

Section 18 Township 23S Range 5W

County DOUGLAS Date 3-6-07

Corner Designation

100440

13/18

Previous Renewals/Surveys, etc. _____

- Condition Report Only
- Not Found
- Renewed
- Unrecorded
- Surveyed In
- Referenced Out

Monument(s) & Accessories Found: (Condition and Source)

1943 BLM IPBC

64" FIR STUMP S18E 153 LKS - ROTTEN

36" FIR STUMP N30W 84 LKS - ROTTEN

8" FIR N59 1/2 W 8 LKS - DID NOT FIND

Monument Detail

Sketch



Monument Set (Procedures and Description)

New Accessories

12" FIR N62W 12¹ SCRIBED "1/4 S BT"

1" FIR S42W 23^B SCRIBED "1/4 S BT"

Location & Comments

Compass Declination 16 1/2°

Firm/Agency ROSEBURG

FOREST PRODUCTS

Address P.O. Box 1088


ROSEBURG OR 97470

Party Chief Bill Olson

Notes _____

Witness KEN COBLE

Surveyor's Seal

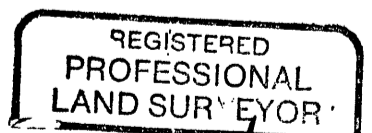

Renews 6/30/08

C.S. File No 65/60-16