

CORNER REPORT FORM

Section 20 Township 25S Range 3W

Douglas County Date 3-07

CORNER DESIGNATION 2A0340

C 14

Condition Report only

Not Found  
Renewed  
Unrecorded  
Surveyed In  
Referenced out

FILED

Date: 4-3-07 By: [Signature]

This survey consists of:

Map: \_\_\_\_\_

Narrative: \_\_\_\_\_

Corner File: 65/60-19

DOUGLAS COUNTY  
SURVEYOR

Previous Renewals/Surveys, etc:

111140-45

Monument(s) & Accessories Found: (Condition and Source)

Fd Alum CAP ON I. ROD  
13" fir N76E 9<sup>9</sup> FT Vis. Scribes  
7" fir S44E 10<sup>1</sup> FT Vis Scribes  
8" fir S44W 19<sup>1</sup> FT Vis Scribes  
16" fir N25W 2<sup>2</sup> FT Vis Scribes

Monument Detail

Sketch

Monument Set (Procedures and Description)

New Accessories

Location & Comments

Surveyor's Seal

Compass Declination



Firm/Agency: i.e. Engineering, Inc.

Address: 505 SE Main  
Roseburg, OR 97470

Party Chief: 117 Fromdah

Notes:

Witness:

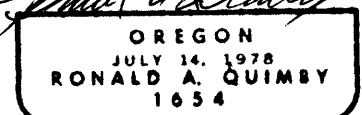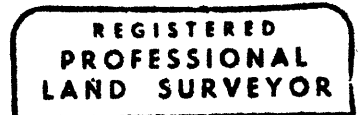

C.S. File No 65/60-19

EXP 12-31-08