

CORNER REPORT FORM

Section 20 Township 25S Range 3W
Douglas County Date 3-07

FILED

CORNER DESIGNATION

300300

20 | 21
29 | 28

Condition Re Date: only 43-07 Pv: X
Not Found
Renewed This survey consists of:
Unrecorded Map:
Surveyed In
Referenced out

Previous Renewals/Surveys, etc:

Corner File 65/60-20

DOUGLAS COUNTY
REGISTERED

Monument(s) & Accessories Found: (Condition and Source)

Fd 1943 GLO BRASS CAP
Rec 3" Hemlock Now 14" N42W 3.5 FT GOOD SCAR
Rec 4" Hemlock Now 15" S9 1/2 E 25.5 FT GOOD SCAR
Rec 4" Fir Now 8" S74 W 6.0 FT GOOD SCAR
Rec 4" Fir Now 14" N34 E 25.4 FT GOOD SCAR

Monument Detail

Sketch

Monument Set (Procedures and Description)

New Accessories

Location & Comments

Surveyor's Seal

Compass Declination



Firm/Agency: i.e. Engineering, Inc.

Address: 505 SE Main
Roseburg, OR 97470

Party Chief: M. Fromdahl

Notes:

Witness:

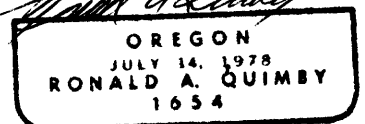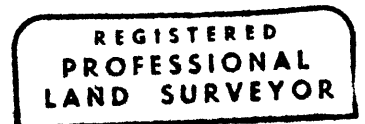

CS. File No 65/60-20

EXP 12-31-08