

CORNER REPORT FORM

Section 20 Township 255 Range 3W

Douglas County Date 3-07

CORNER DESIGNATION

C-E 1/16

Condition Report only

- Not Found
- Renewed
- Unrecorded
- Surveyed In
- Referenced out

Previous Renewals/Surveys, etc:

M 140-45

Monument(s) & Accessories Found: (Condition and Source)

Fd Alum CAP ON I. ROD  
 6" fir N87E 4 FT Vis Scribes  
 89" fir N42W 4 FT Vis Scribes

FILLED

Date: 4/3/07 By: X

This survey consists of:

Map: \_\_\_\_\_

Narrative: \_\_\_\_\_

Corner book: 65/60-21

DOUGLAS COUNTY  
309

Monument Detail

Sketch

Monument Set (Procedures and Description)

New Accessories

Location & Comments

Surveyor's Seal

Compass Declination



Firm/Agency: i.e. Engineering, Inc.

Address: 505 SE Main  
Roseburg, OR 97470

Party Chief: M. Fromdahl

Notes:

Witness:

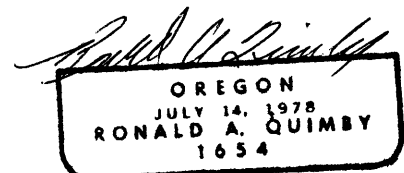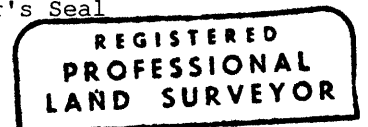

C.S. File No 65/60-21

EXP 12-31-08