


CERTIFIED RECORD OF LAND CORNER MONUMENTATION

History of original corner establishment: Northwest 1/16 corner of section 29, T. 32 S., R. 2 W., W. M.  
S-6

William J. Ruppert, L.S. 866, established the corner in 1980 for the subdivision of section 29 (Jackson County index no. 8438/ Douglas County M84-5/CS file 58/143-23). He set a 2"x30" aluminum pipe with a 2-1/2" aluminum cap, marked as shown. Ruppert established new bearing trees: a 14" D. Fir, N. 24° 15' W., 14.2 ft., marked "NW1/16 S29 BT"; and a 12" D. Fir, N. 35° 25' W., 6.8 ft., marked "NW1/16 S29 BT". A 3/4" brass washer, marked "LS 866", is attached to lower blaze of each new BT.

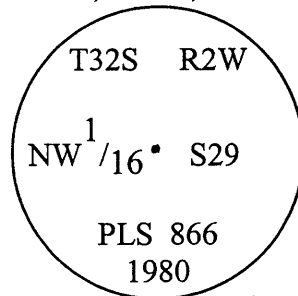

Description of corner evidence found: September 26, 2007

I found a 2-1/2 inch outside diameter aluminum pipe, firmly set, projecting 4 inches above ground, with a 2-1/2 inch diameter brass cap attached, marked as above.

From which the following bearing trees established in 1980:

- a 18" Douglas fir, bears N. 36-1/4° E., 6.8 feet, (rec. N. 35° 26' W. was a typo, tag states bearing for a NE BT) with healed double blaze.
- a 20" Douglas fir, bears N. 14-1/2° W., 14.2 feet, (rec. N. 24° 15' W. was a typo, tag states bearing is N. 14° 24' E.) with healed double blaze.

Description of monument and accessories I established to perpetuate the original location of this corner: September 26, 2007


I add new accessories to perpetuate the corner:

- a found aluminum post, bears S. 85° W., 3.9 feet, projecting 4 feet above the ground, with Forest Service signs #54-2 "Property Boundary" and #54-9 "Land Survey Monument" attached.
- a found aluminum post, bears N. 2-3/4° W., 4.9 feet, projecting 4 feet above the ground, with Forest Service sign #54-2 "Property Boundary".

With a staff compass I sighted on the posted section subdivision lines, which have a platted bearing of N. 1° 28' 37" W. and N. 87° 48' 57" W. as my basis of bearings. I determined the magnetic declination to be 16-1/4° East. Trees are measured to the center of the root crown. Tree diameters are at breast height. This corner was in the 1987 Angle Fire and the bearing trees are burned on one side, but still healthy. 375± feet southerly of the road junction with 3232-870, the corner is 400± feet West of Forest Service road No. 3232-872 at point of timber visible along timber line.

My certificate expires June 30, 2009

Leonard E. Herzstein, L.S. 2150  
Umpqua National Forest  
2900 NW Stewart Parkway  
Roseburg, OR 97470

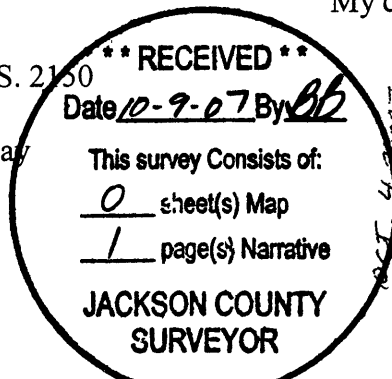

C.S. File No 65/60-38