

CERTIFIED RECORD OF LAND CORNER MONUMENTATION

History of original corner establishment:

GLO survey by W.H. Byars, Deputy Surveyor, under Contract No.152, dated June 3, 1871, - (DCSO records Vol. 18 Page(7689)

Set post cor. to secs. 1, 2, 35 and 36, from which:

- No tree in sec. 36 in limits.
- A Pine 30" dia., bears S.62°E., 105 lks. dist.
- A Laurel 8" dia., bears S.50°W., 57 lks. dist.
- A Pine 30" dia., bears N.42°W., 115 lks. dist.

DIAGRAM
T31S R3W
S35 | S36
S2 | S1
T32S R3W
GCDB 600100

GLO survey by William Bushey, Deputy Surveyor, under Contract No. 620, dated June 17, 1893 (DCSO records Vol. 18 Page(7694)

The Sec. cor. is destroyed by fire. I find 2 of the witness trees. At cor. point, Set a stone 15x11x7 ins., 10" in the ground for corner, marked with 1 notch on E. and 5 notches on W. edges; from which:

- A Laurel 8" dia., now 10", bears S.50°W., 57 lks. dist. mkd. T32S R3W S2 BT.
- A Pine 30" dia., bears N.42°W., 115 lks. dist. mkd. T31S R3W S35 BT.

These are the original witness trees. The Laurel in sec. 2 is broken off 10 ft. above the ground. The Pine in Sec. 1 is destroyed by fire.

I mark 2 new witness trees as follows:

- A Pine 12" dia., bears S.12½°E., 270 lks. dist. mkd. T32S R3W S1 BT.
- A Pine 14" dia., bears S.31°W., 160 lks. dist. mkd. T32S R3W S2 BT.
- No tree in sec. 36 in limits.

Douglas Co. Surveyors Office - John M. Powell, Frank Jones & Joe Brady, Mike Stone; Jack Heritage, crew -April 1966 - C.S. File 52/63: No trace of corner stone.

- Found - 30" Pine now 53", N.42°W., 75.9 ft., scribe visible "35".
- 10" Laurel S.50°W., 37.6 ft., no trace of this tree.
- 12" Pine now 38", S.12½°E., 178.2 ft., shows scar.
- 14" now 31" Pine S.31°W., 105.6 ft., scribe visible "2".

Set Brass cap at cor. mkd: "County Surveyors Office T31S R3W S35 S36 S2 S1 1966"

- New BTs: 8" Laurel S.42°E., 26.9 ft. scribed T31S R3W S1 CS BT
- 6" Laurel N.68°E., 5.2 ft. scribed T31S R3W S36 CS BT.

Reblazed and rescribed: 53" Pine N.42°W., 75.9 ft. scribed T31S R3W S35 CS BT.

Description of corner evidence found:

A 1 3/8" diam. galvanized iron post, firmly set, projecting 12" a 6" high x 18" diam. mound of stone with a 2 1/2" brass cap stamped:

COUNTY SURVEYORS OFFICE
 T31S
 S35 | S36
 S2 | S1
 T32S R3W
 1966

from which an original bearing tree by Byars in 1871:

A 49" Pine snag bears N.42°W., 77.1 ft. with scribe marks "W S35 CS B" visible on a partially healed single blaze (Rec. N.42°W., 115 lks.)

and bearing trees by Bushey in 1893:

A 42" Pine bears S.12½°E., 178.2 ft. with a deep partially healed single blaze. (Rec. S.12½°E., 270 lks.)

A 38" Pine bears S.31°W., 105.6 ft. with a healed single blaze. (Rec. S.31°W., 160 lks.)

and bearing trees by Powell in 1966:

A 8" madrone bears N.68°E., 5.3 ft. with a healed single blaze. (Rec. N.68°E., 5.2 ft.)

A 9" madrone bears S.42°E., 27.0 ft. with illegible scribe marks visible on a partially healed single blaze. (Rec. S.42°E., 26.9 ft.)

Description of monument and accessories established to perpetuate the original location of this corner:


I scribe new bearing trees:

A 12" D.fir bears N.56°W., 35.9 feet, scribed "T31S R3W S35 BT".

All new bearing trees have double blazed faces with a brass washer stamped "PLS 1941" nailed into the lower blaze.

Bearings are taken to the center of the tree at the root crown and distances are measured to an aluminum nail in the root crown at the side and center of the tree. All bearing trees have a 6" red band painted around the tree and the blazed face painted red and Bearing Tree and USFS Land Survey Monument sign nailed to the tree.

- Corner renewal date: June 29, 2007
- Party Chief: Lester Fanning, PLS 2664
- Witnesses: Scott McCurdy, Sam Clayton
- Warren Knight Staff Compass -- declination 18°E
- By: BTS Engineering & Surveying, Inc.
 431 SE Main
 Roseburg, OR 97470

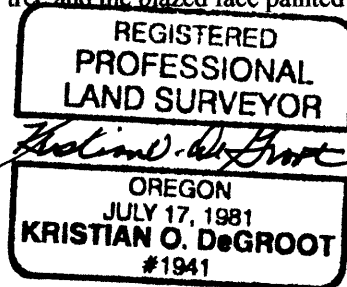

**RENEWAL 12/31/07
 FILED**

Date: 11-7-2007 By: JC

This survey consists of:

M: _____

N: _____

Corner: 65/60-42

**DOUGLAS COUNTY
 SURVEYOR
 C.S. File No 65/60-42**

Douglas County Surveyor's Office Douglas County, Oregon
 I hereby certify that the written instrument was filed in this office for record on the 7 day of NOVEMBER, 2007.

Romey Ware by [Signature]
 (County Official) (Deputy)