


CERTIFIED RECORD OF LAND CORNER MONUMENTATION

History of original corner establishment: T. 27 S., R. 6 E., W. M. 300140
X-9

Samuel C. Flint, U.S. Deputy Surveyor, in 1883, established the one-quarter corner for sections 32, and 33. He set a post and marked bearing trees, a fir, 7" diam., S. 30° E., 29 lks., marked "1/4S.B.T.", a fir, 5" diam., S. 5° W., 11 lks., marked "1/4S.B.T."

Dennis Gaylord, Deputy County Surveyor, perpetuated the corner in 1977 (C.S. File 59/-40). He found the original BT: fir stump, S. 5°W., 7.26 feet, with a downed log with scribe marks "1/4 S BT" visible on double blaze (face is at 2" diam.). The original SW BT is gone. From the original bearing tree, Gaylord set a 1" iron pipe with a 2-1/2" brass cap stamped as shown. He marked new BTs: an 11" lodgepole pine, S. 11° E., 36.6 ft., scribed "1/4 S33 CS BT" on a double blaze; and an 8" lodgepole pine, S. 37° W., 45.7 ft., scribed "1/4 S32 CS BT" on a double blaze.

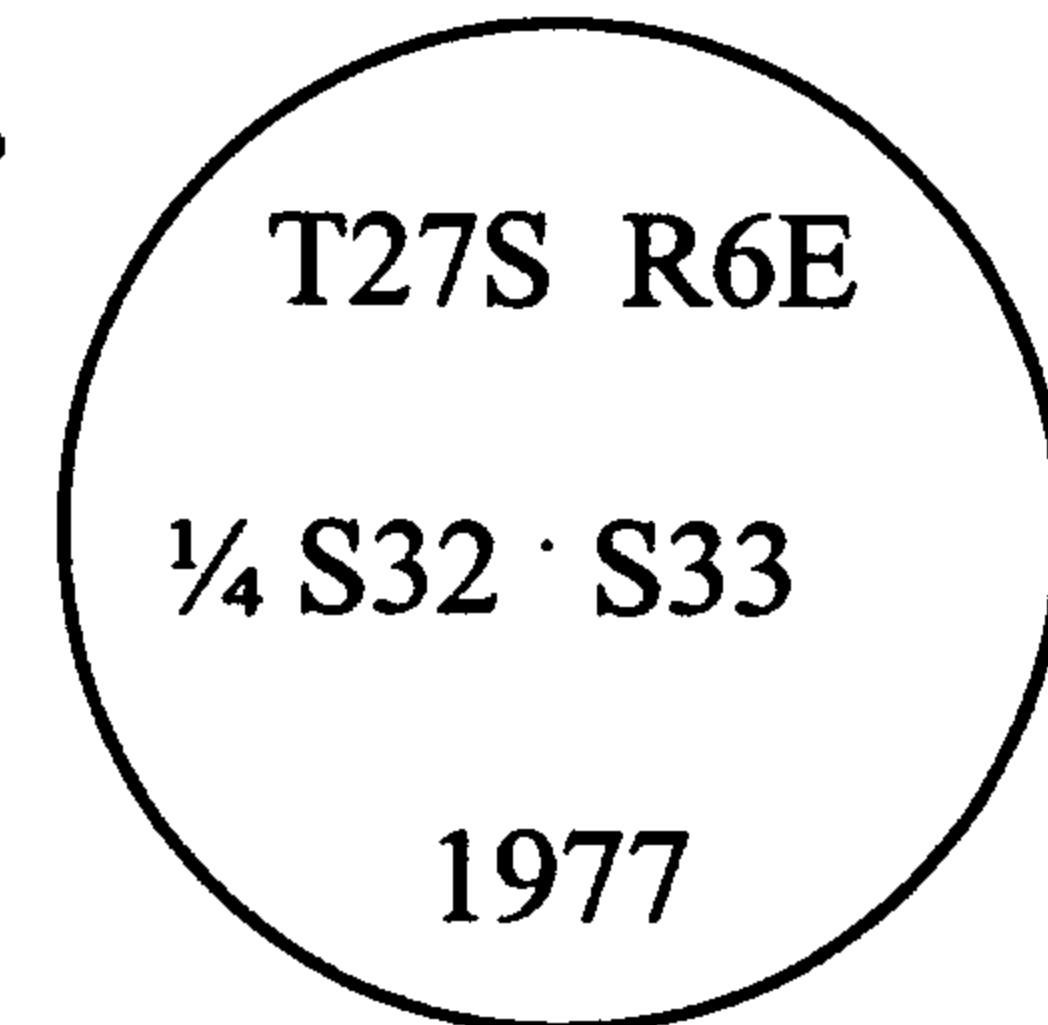

Randall W. Smith, Deputy County Surveyor, further perpetuated the corner in 1998 (C.S. File 66/4-3). He found a 2-1/2" brass cap on 1-1/2" outside diameter iron pipe protruding 4" above the ground. He found the remains of the original BT: pine remnants, S. 5°W., 7.3 feet, with scribe marks "1/4". He found BTs marked in 1977: a 12" lodgepole pine snag, S. 11° E., 36.6 ft., with scribe marks "1/4 S33 CS BT" visible on unhealed double blaze; a 9" lodgepole pine, S. 37° W., 45.7 ft., with scribe marks "1/4 S32 CS BT" visible on unhealed double blaze. Smith marked new BTs: a 7" lodgepole pine, N. 71° W., 30.4 ft., scribed "1/4 S33 CS BT" on a double blaze; an 8" lodgepole pine, S. 34° E., 13.4 ft., scribed "1/4 S33 CS BT" on a double blaze; and a 4" lodgepole pine, N. 50° W., 19.1 ft., scribed "X BT" on a double blaze.

Description of corner evidence found: June 20, 2000

I found a 1-1/2 inch outside diameter iron pipe, firmly set, projecting 4 inches above the ground, with a 2-1/2 inch diameter aluminum cap attached and marked as shown above.

From which, bearing trees marked by Gaylord in 1977:

- A 12" lodgepole pine snag, S. 11° E., 36.6 feet, with scribe marks "1/4 S33" "CS BT" visible on a partially healed double blaze.
- A 9" lodgepole pine, S. 38° W., 45.7 feet, with scribe marks "1/4 S32" "CS BT" visible on a partially healed double blaze.

And bearing trees marked by Smith in 1998:

- A 6" lodgepole pine, N. 73° 15' E., 29.7 feet (rec. N. 71° E., 30.4 feet), with scribe marks "1/4 S33 CS" "BT" visible on partially healed double blaze.
- A 9" lodgepole pine, S. 34° E., 13.4 feet, with scribe marks "1/4 S33 CS" "BT" visible on partially healed double blaze.

- A 4" lodgepole pine, N. 47° 30' W., 19.1 feet (rec. N. 50° W.), with scribe marks "X" "CS BT" visible on partially healed double blaze.

Description of monument and accessories I established to perpetuate the original location of this corner: August 31, 2004

And new bearing objects I established:

- A 6-foot aluminum post, N. 4° 30' E., 1.8 feet, driven 1.5 feet in the ground with Forest Service sign #54-9 "Land Survey Monument" attached.
- A found 1-1/2" aluminum cap, S. 41° 11' W., 70.00 feet, flush with the ground and marked "ODOT HORIZ CONTROL 240".
- A found 1-1/2" aluminum cap, N. 24° 05' W., 73.82 feet, flush with the ground and marked "ODOT HORIZ CONTROL 239".

I used the inverse of 2 Trimble Pathfinder Professional observations (one-half mile apart) as my basis of bearings. With a 10-second total station, I traversed the section line to the section corner of sections 28, 29, 32 and 33 and I found the bearing and distance to be S. 00° 24' 25" W., 2661.59 feet. My bearings are from the field traverse and are rounded to the nearest 15 minutes, except for the two aluminum caps which are rounded to the nearest minute. Trees are measured to the center of the root crown. Tree diameters are at breast height.

The corner is S. 81° 26' 24" E., 338.20 feet from Angle Point 1147B of the Oregon Cascade Recreation Area boundary and S. 44° 35' 55" E., 1435.41 feet from Douglas County's Kristi Azimuth mark along Highway 138. The corner is in a dry creek bed coursing southeasterly, 833 feet East of the centerline of Highway 138 at mile post 79.8.

Witnesses: Tim Schmid
Erica Goldman
Joseph Darneille
Leonard Brown

My certificate expires June 30, 2009

Leonard E. Herzstein, L.S. 2150
Umpqua National Forest
2900 NW Stewart Parkway
Roseburg, OR 97470



FILED

Date: 12-4-2007 By: JC

This survey consists of:

Map: _____

Narrative: _____

Corner Rpt: 65/60-53 A & B

**DOUGLAS COUNTY
SURVEYOR**

C.S. File No 65/60-53^(B)