

FILED

Date: 1-23-2008 By: J C

This survey consists of:

Map: _____

Narrative: _____

Corner Rpt: 65/63-1

CORNER REPORT FORM

Section 22 Township 29S Range 8W

Douglas County

Date 1/2008

CORNER DESIGNATION

600400

14/13
23/24

DOUGLAS COUNTY
Condition Report only

- Not Found
- Renewed
- Unrecorded
- Surveyed In
- Referenced out

Previous Renewals/Surveys, etc:

BLM 1975

Monument(s) & Accessories Found: (Condition and Source)

FJ 1924 GLO BRASS CAP

<u>FJ</u>	<u>12" MADRONA</u>	<u>N33E</u>	<u>132 FT</u>
	<u>9" CEDAR</u>	<u>N40E</u>	<u>52 FT</u>
	<u>42" FIR</u>	<u>S37E</u>	<u>312 FT</u>
	<u>16" FIR</u>	<u>N7W</u>	<u>104 FT</u>
	<u>11" CEDAR</u>	<u>S36 1/2 W</u>	<u>312 FT</u>

Monument Detail

Sketch

1924 GLO BRASS CAP

Monument Set (Procedures and Description)

New Accessories

Location & Comments

Surveyor's Seal

Compass Declination



Firm/Agency: i.e. Engineering, Inc.

Address: 505 SE Main
Roseburg, OR 97470

Party Chief: M. FROMDAHL

Notes:

Witness:

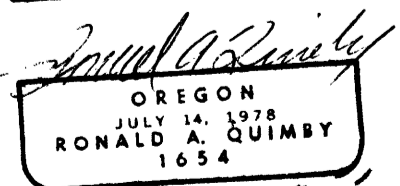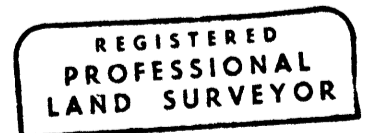

C.S. File No 65/63-1

EXP 12-31-08