


M114-78

FILED
Date: 3-18-2008 By: X
This survey consists of:
Map: 6
Narrative:
Corner Rpt. CS 65/63-13

S16 T32S R 5W

DOUGLAS COUNTY
SURVEYOR

NORTH HALF

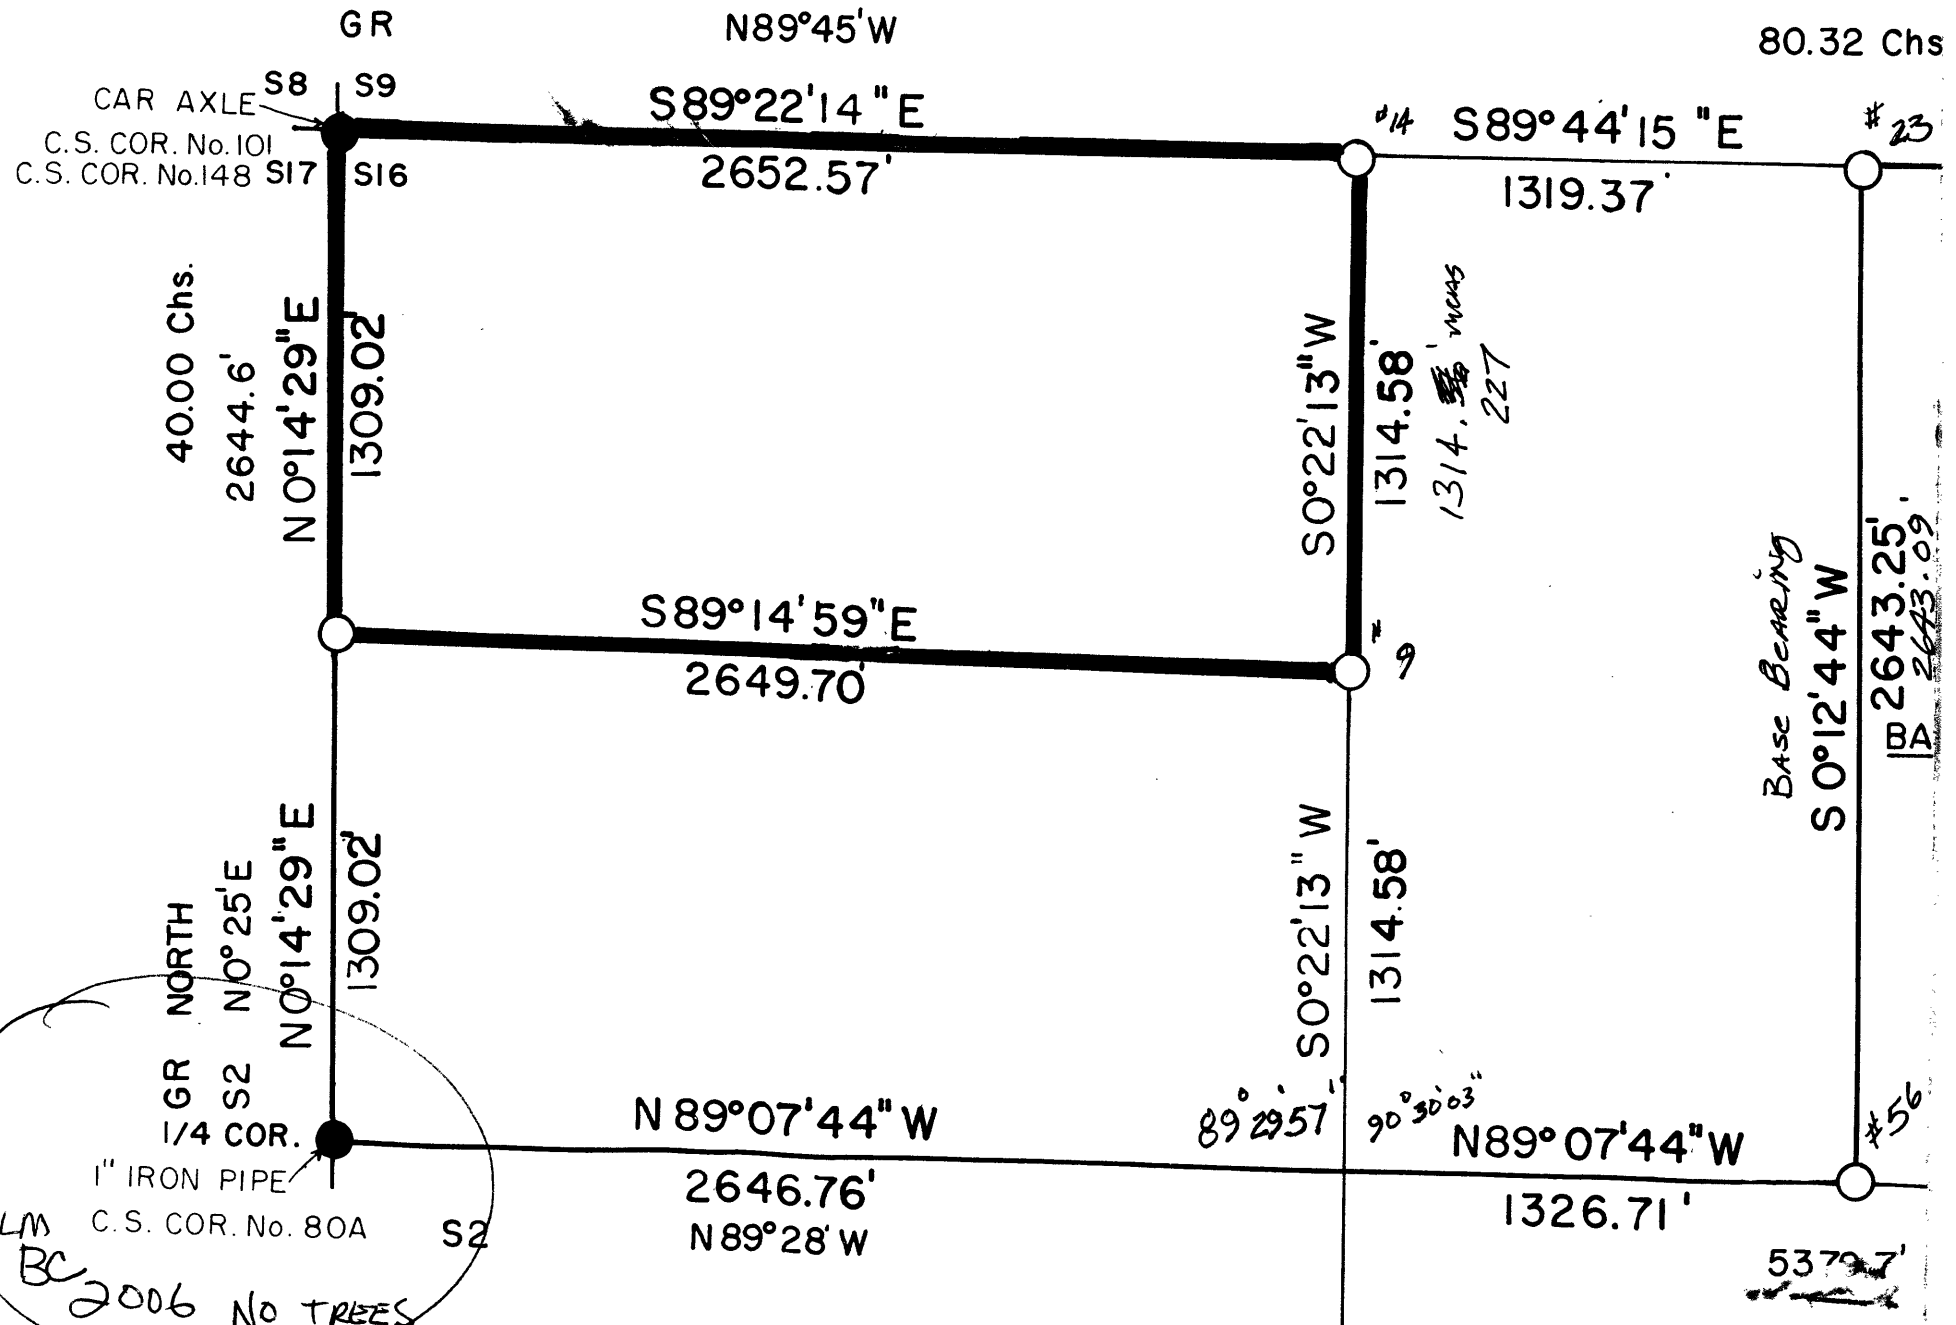

March 17, 2008

JEAN,
BTS REPORTED
finding 30% BLM
BRASS caps
NO NEW TREES
Did NOT SEE anything
IN CS A2/A04
They were going to
CALL AL SKESICK

BLM BC 2006 NO TREES

C.S. File No 65/63-13

SURVEY FOR
MEDFORD CORPORATION