


**CORNER RENEWAL**  
East One-Sixteenth of Sections 21 and 28, T. 29 S., R. 7 W., W.M.  
GCDB 360300

**Description of Monument and Accessories Found: March 31, 2008**

I found a 2-1/4 inch outside diameter iron pipe, firmly set by John M. Jelley, B.L.M. Cadastral Surveyor, in 1966, projecting 6 inches above the ground, with a 3-1/4 inch diameter brass cap attached and marked as shown.

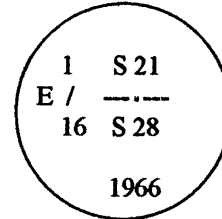

From which the bearing trees marked by Jelley in 1966:

- A 15" ponderosa pine snag, bears S. 49° 40' W., 21.1 feet (record S. 51° W., 31 links = 20.46 feet), with healed blaze.
- A 20" ponderosa pine snag, bears N. 71° 30' W., 31.7 feet, with fragmentary scribe marks visible on a partially healed blaze.

**Description of Monuments and Accessories Established to Perpetuate the Corner: April 11, 2008**


I mark new bearing trees:

- An 8" Douglas fir, bears S. 71° 30' W., 29.4 feet, scribed "E1/16 S28 BT" on a single blaze.
- A 10" Douglas fir, bears N. 76° 10' W., 12.2 feet, scribed "E1/16 S21 BT" on a single blaze.

Bearings are determined by backsighting the 1966 B.L.M. and the 1992 M114-65 record bearing of N. 89° 15' W. on the blazed section line and turning angles with a transit to the bearing trees. The bearings are rounded to the nearest 10 minutes. New bearing trees have a 3/4 inch diameter brass washer, stamped "LS 2150", nailed flush to the base of the blaze. Measurements are to the tree rootcrown. Tree diameters are measured at breast height.

Leonard E. Herzstein  
1741 Byron Creek Road  
Winston, Oregon 97496

My Current Certificate  
Expires 06/30/2009

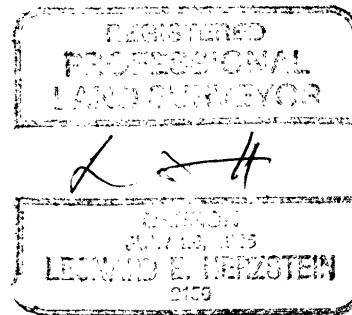

MAY 1, 2008

FILED

Date: 5/19/2008 By: JC

This survey consists of:

Map: \_\_\_\_\_

No. \_\_\_\_\_

Corner Rpt: 65/63-14

DOUGLAS COUNTY  
SURVEYOR