

CORNER RENEWAL
Center East One-Sixteenth of Section 28, T. 29 S., R. 7 W., W.M.
GCDB 360240

Description of Monument and Accessories Found: February 28, 2008

I found a 1-1/4 inch outside diameter iron pipe, firmly set by Victor McLind, L.S. 934, on RM2-35 in 1972, projecting 12 inches above the ground, with a 2-1/4 inch diameter brass cap attached and marked as shown.

T29S R7W

CE 1/16 S28
RLS 934

1972

From which the bearing tree and the accessory by McLind in 1972:

- A 2" inside diameter iron pipe, found lying on the ground out of position.
- A 24" Douglas fir cut stump, bears S. 73° 10' W., 20.6 feet (record S. 84° W., 20.9 feet per RM2-35), with a healed blaze.

Description of Monuments and Accessories Established to Perpetuate the Corner: April 30, 2008



I mark new bearing trees:

- An 11" Douglas fir, bears S. 78° 00' E., 9.9 feet, scribed "CE1/16 S28 BT" with a 3/4 inch diameter brass washer, stamped "LS 2150", nailed flush to the base of a single blaze.
- A 12" Douglas fir, bears N. 25° 50' W., 6.2 feet, scribed "CE1/16 BT" with a 3/4 inch diameter brass washer, stamped "LS 2150", nailed flush to the base of a single blaze.

Bearings are determined by a traverse to the Center one-quarter corner and using the 1972 RM2-35 record bearing of N. 89° 05' 32" W. on the section East-West centerline. The bearings are rounded to the nearest 10 minutes. Measurements are to the tree rootcrown. Tree diameters are measured at breast height. The corner is at the top of a rock bluff facing North.

Leonard E. Herzstein, L.S. 2150
1741 Byron Creek Road
Winston, Oregon 97496

My Current Certificate
Expires 06/30/2009

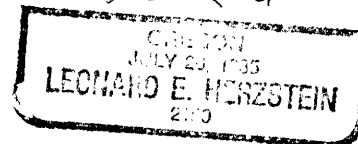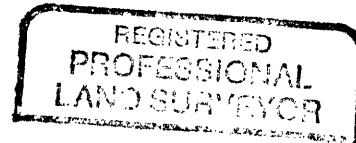

May 2, 2008

FILED

Date: 5/19/2008 By: JC

This survey consists of:

Map: _____

Narrative: _____

Corner Rpt: 65/63-15

**DOUGLAS COUNTY
SURVEYOR**

C.S. File No 65/63-15