

OREGON CORNER RESTORATION FORM

Section 22 Township 21 South, Range 7 West
County Douglas Date 22 July 2008

FILED
Date: 7/30/08 By: SC
This survey consists of:
Map: _____
Narrative: _____
Corner Rpt: 65/63-25
DOUGLAS COUNTY
SURVEYOR

Corner Description

Southwest corner
of section 22

- Condition Report Only
- Not Found
- Renewed
- Unrecorded
- Surveyed In
- Referenced Out

Previous Renewals / Surveys, etc.

Monument (s) & Accessories Found: (Condition and Source)


Found 3-1/4" brass cap dated 1964 with the following accessories:

- 72" D. fir bears N80°E 35.0' – healed face
- 47" W. red cedar bears N28°W 37.6' – healed face
- 22" Hemlock bears N68-3/4°E 31.7' – healed face
- 58" D. fir snag bears N52°W 8.6' – healed face

Monument Detail

Sketch

Monument Set (Procedures and Description)
None

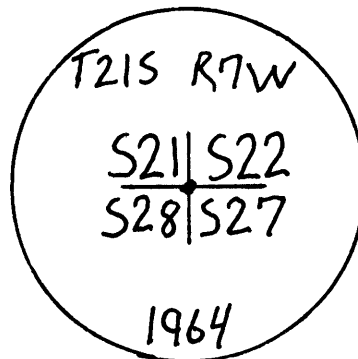


New Accessories
None

Location & Comments

Corner has steel post _____ Compass Declination 17° East
adjacent to it. _____ Firm/Agency Ward NorthWest Inc.
All BT's have red painted _____
bands and yellow tags. _____ Address P.O. Box 105
_____ Florence, OR 97439
_____ Party Chief Ron Rice
_____ Notes _____
_____ Witness Josh Reed

Surveyor's Seal

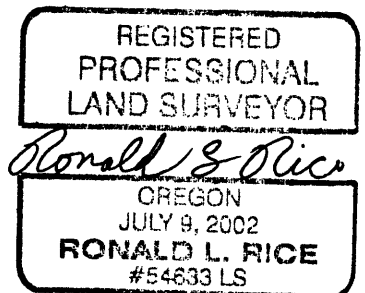

Expires: 12-31-08

C.S. File No 65/63-25