

FILED

Date: 8-13-2008 By: JC

This survey consists of:

Map: _____

Narrative: _____

Corner Rpt: 65/63-27

DOUGLAS COUNTY
SURVEYOR

OREGON CORNER RESTORATION FORM

Section 8 Township 23 South, Range 8 West

County Douglas

Date 8 August 2008

Corner Description

1/4 Corner

Sections 8, 9

Condition Report Only

Not Found

Renewed

Unrecorded

Surveyed In

Referenced Out

Previous Renewals / Surveys, etc.

Monument (s) & Accessories Found: (Condition and Source)

Found 3" brass cap dated 1966 with the following accessories:

20" D. fir bears S36°E 30.1' – healed face

13" D. fir bears N56°E 33.5' – healed face (not of record)

19" X 4' D. fir stump bears S26°W 50.0' – healed face (not of record)


16" X 4' D. fir stump bears S83°W 21.4' – healed face (not of record)

Monument Detail

Sketch

Monument Set (Procedures and Description)

None

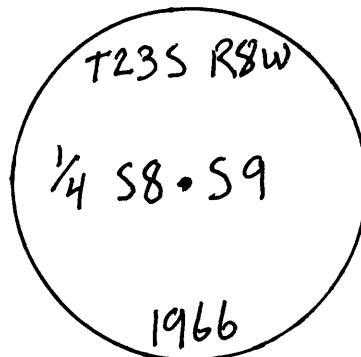

New Accessories

None

Location & Comments

Corner has steel post

adjacent to it.

All BT's have red painted

bands and yellow tags.

Compass Declination 17° East

Firm/Agency Ward NorthWest Inc.

Address P.O. Box 105


Florence, OR 97439

Party Chief Ron Rice

Notes _____

Witness Josh Reed

Surveyor's Seal

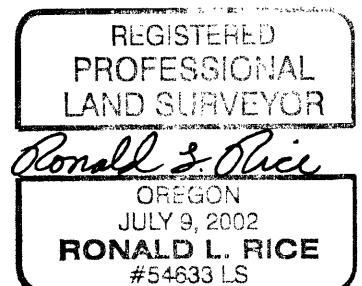

Expires: 12-31-08

C.S. File No 65/63-27