

OREGON CORNER RESTORATION FORM

Section 8 Township 21 South, Range 8 West  
County Douglas Date 15 August 2008

FILED  
Date: 8/26/2008 By: JC  
This survey consists of:  
Map: \_\_\_\_\_  
Narrative: \_\_\_\_\_  
Corner Rpt: 65/63-29  
DOUGLAS COUNTY  
SURVEYOR

Corner Description

Southeast corner  
of section 8

- Condition Report Only
- Not Found
- Renewed
- Unrecorded
- Surveyed In
- Referenced Out

Previous Renewals / Surveys, etc.

Monument (s) & Accessories Found: (Condition and Source)


Found 2-1/2" brass cap dated 1945 with the following accessories:

- 25" D. fir bears N70-3/4°W 77.9' – healed face
- 18" D. fir bears S60-3/4°W 16.5' – healed face
- 70" D. fir stump bears N84-1/2°E 24.4' – scribing visible
- 23" X 4' D. fir stump bears S46-1/2°E 93.7' – healed face

Monument Detail

Sketch

Monument Set (Procedures and Description)  
None

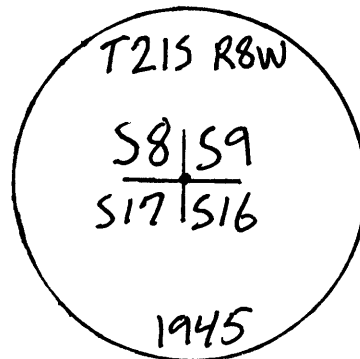

New Accessories  
None

Location & Comments

Corner has steel T-post adjacent to it. Compass Declination 17° East  
Firm/Agency Ward NorthWest Inc.  
All BT's have red painted bands and yellow tags. Address P.O. Box 105  
Florence, OR 97439  
Party Chief Ron Rice  
Notes \_\_\_\_\_  
Witness Josh Reed

Surveyor's Seal



Expires: 12-31-08