

Date: 10-6-2008 By: JC
This survey consists of:
Map: _____
Narrative: _____
Corner Apt: 65/63-31

RECORD OF LAND CORNER PERPETUATION

DOUGLAS COUNTY
SURVEYOR


The 1/4 corner common to sections 2 and 11, Township 31 South, Range 6 West, Willamette Meridian, Douglas County, Oregon

Found County Surveyor monument, with brass cap marked as shown in diagram, set in 1966, from which:

- A fir snag, 38" diameter, bears N69°45'W, 16.3 ft. dist.
- A fir, 20" diameter bears S30°30'E, 22.6 ft. dist. with healed blaze
- A rotten fir stump, bears S36°45'E, 29.2 ft. dist.

Marked new bearing tree:

- A pine, 15" diameter bears N49°W, 54.6 ft. marked '1/4 S2 BT'

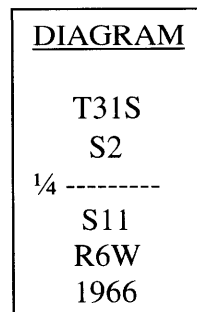

Basis of bearing: N-S centerline of section 2 as per record survey M65-68, N0°16'16"W; distances to BT's taken to side center.

Corner lies on broad ridge, in fence line +/- ft. 200 south of cattle guard on FS road 1610-050.

USDA Forest Service
3040 Biddle Rd.
Medford, Or. 97504

March 17, 2008
Witnesses:
Lance Goucher
Andrew Hillman

Roberta Romio, OR PLS 2878

