

**CERTIFIED RECORD OF LAND CORNER MONUMENTATION**

**History of original corner establishment:**

For U.S. Forest Service by Ronald A. Quimby and Duane L. Scroggins, (per M 79-57), dated July and August, 1980:

Set 2 1/2" iron pipe with brass cap (marked as shown) from which bears:

T27S R1W  
S 1/16  
S14 | S13  
RLS 1320 1980

Scribe new B.T.'S

54" D. Fir S.70°W., 31.5 ft. "S 1/16 S14 B.T."

30" D. Fir N.8°E., 13.5 ft. "S 1/16 S13 B.T."

Brass washer marked RLS 1654 in B.T. faces

Set Post and Sign 4.0' east

**DIAGRAM**

T27S R1W

S 1/16

S14 | S13

PLSS 600420

FILED

Date: 11-24-2008 By: J

This survey consists of:

Map: \_\_\_\_\_

Narrative: \_\_\_\_\_

Corner Rpt: 65/63-35

DOUGLAS COUNTY

SURVEY

**Description of corner evidence found:**

I find a 2 1/2" iron post exposed 8" above a 48" diam. stone mound with a 2 1/2" diam. brass cap stamped:

(Note: iron post is solid in stone mound but leans S.55°W, ± 20°)



From which bearing trees by Quimby and Scroggins in 1980:

Was 30", now 30" D. Fir bears N.8°E., 13.5 ft. with a healed double face.

Was 54", now 42" broken off, 8 ft. tall, D. Fir snag bears S.70°W., 31.5 ft. with remains of log lying against inaccessible double face.

**Description of monument and accessories established to perpetuate the original location of this corner:**

I scribe a new bearing tree:

A 27" D. Fir bears N.80°W., 46.8 ft. which I scribed "S 1/16 S14 BT" on a double face.

All new bearing trees have double blazed faces with a brass washer stamped "PLS 1941" nailed into the lower blaze. Bearings are taken to the center of the tree at the root crown and distances are measured to an aluminum nail in the root crown at the side and center of the tree. All bearing trees have a 6" red band painted around the tree and the blazed face painted red and Bearing Tree and USFS Land Survey Monument sign nailed to the tree.

Corner renewal date: June 27, 2008

Party Chief: Lester Fanning, PLS 2664

Witnesses: Adam DeGroot, Scott McCurdy, and Rick Sanford

Warren Knight Staff Compass -- declination 19°E

By: BTS Engineering & Surveying, Inc.

431 SE Main

Roseburg, OR 97470


Douglas County Surveyor's Office

Douglas County, Oregon


I hereby certify that the written instrument was filed in this office for record on the 24<sup>th</sup> day of November, 2008.

Romey Ware  
(County Official)

by [Signature]  
(Deputy)

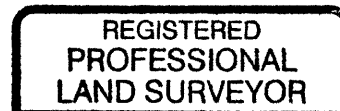

[Signature]

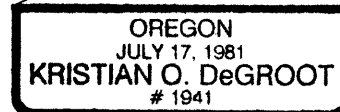

RENEWAL 12/31/09

C.S. File No 65/63-35