

OREGON CORNER RESTORATION FORM

Section 26 Township 24 South, Range 8 West  
County Douglas Date 10 Decembert 2008

FILED  
Date: 12/10/2008 By: JC  
This survey consists of:  
Map: \_\_\_\_\_  
Narrative: \_\_\_\_\_  
Corner Rpt: 65/63-39

DOUGLAS COUNTY  
SURVEYOR

Corner Description

Sourtheast corner  
of section 26

- Condition Report Only
- Not Found
- Renewed
- Unrecorded
- Surveyed In
- Referenced Out

Previous Renewals / Surveys, etc.


Monument (s) & Accessories Found: (Condition and Source)

Found 3" brass cap dated 1958 with the following accessories:

- 41" D. fir bears N85°E 34.3' – healed face
- 37" D. fir bears S80°E 27.7' – healed face
- 19" White fir bears S51°E 18.7' – healed face
- 15" D. fir bears West 19.6' – healed face
- 23" Hemlock bears N72°W 27.2' – healed face
- 25" Incense cedar bears N75°E 42.0' – healed face

Monument Detail

Sketch

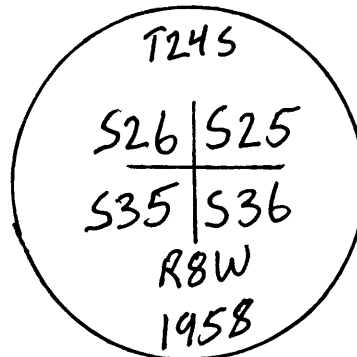

Monument Set (Procedures and Description)

None

New Accessories

Location & Comments

Corner has aluminum Compass Declination 17° East  
post adjacent to it. Firm/Agency Ward NorthWest Inc.  
All BT's have red painted  
bands and yellow tags. Address P.O. Box 105  
 Florence, OR 97439  
 Party Chief Ron Rice  
 Notes \_\_\_\_\_  
 Witness Josh Reed

Surveyor's Seal



RENEWS: 12-31-2010

C.S. File No 65/63-39