

OREGON CORNER RESTORATION FORM

FILED

Date: 12/11/2008 By: J.C.

This survey consists of:

Map: _____

Narrative: _____

Corner Rpt: 65/63-40

Section 26 Township 24 South, Range 8 West
County Douglas Date 10 December 2008

DOUGLAS COUNTY

Corner Description

1/4 Corner
Sections 26, 35

- Condition Report Only
- Not Found
- Renewed
- Unrecorded
- Surveyed In
- Referenced Out


Previous Renewals / Surveys, etc.

Monument (s) & Accessories Found: (Condition and Source)

Found 3-1/4" brass cap dated 1986 with the following accessories:
35" W. Red cedar bears S40°E 38.3' – opened face, no marks visible
40" W. Red cedar bears S9°E 23.1' – scribing visible
36" White fir (record Hemlock) bears N53°E 67.3' – healed face

Monument Detail

Sketch

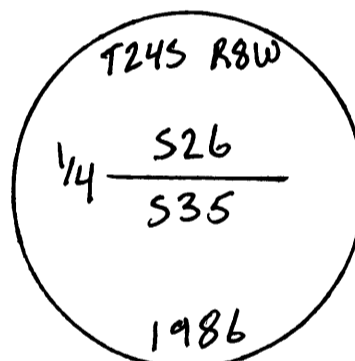

Monument Set (Procedures and Description)

None

New Accessories

28" Myrtle bears N45°W 51.6' – blazed, scribed "1/4 S26 BT"

Location & Comments

Corner has steel post adjacent to it. Compass Declination 17° East
All BT's have red painted bands and yellow tags. Firm/Agency Ward NorthWest Inc.
 Address P.O. Box 105
Florence, OR 97439
 Party Chief Ron Rice
 Notes _____
 Witness Josh Reed

Surveyor's Seal



RENEWS: 12-31-2010

C.S. File No 65/63-40