

OREGON CORNER RESTORATION FORM

Section 24 Township 23 South, Range 5 West
County Douglas Date 3 February 2009

FILED
Date: 2-10-2009 By: JC
This survey consists of:
Map: _____
Narrative: _____
Corner Rpt: 65/66-8
DOUGLAS COUNTY
SURVEYOR

Corner Description

NE Corner
Section 24

- Condition Report Only
- Not Found
- Renewed
- Unrecorded
- Surveyed In
- Referenced Out

Previous Renewals / Surveys, etc.


Monument (s) & Accessories Found: (Condition and Source)

Found 2-1/2" Douglas County brass cap dated 1963 with the following accessories:

- 50" Fir bears N 60° W 46.9' visible bark scribing
- 45" Cedar bears N 61° E 222.4' healed face
- 51" Fir bears S 7-1/2° E 198.7' healed face
- 60" Fir bears S 17° W 180.2' healed face

Monument Detail

Sketch

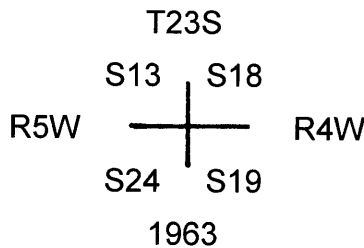

Monument Set (Procedures and Description)

None

New Accessories

None

Location & Comments

Corner has steel post _____ Compass Declination 17° East
adjacent to it. _____ Firm/Agency Ward NorthWest Inc.
All BT's have red painted _____
bands and yellow tags. _____ Address P.O. Box 105
_____ Florence, OR 97439
_____ Party Chief Ron Rice
_____ Notes _____
_____ Witness Josh Reed

Surveyor's Seal



RENEWS: 12-31-2010

C.S. File No 65/66-8