

FILED

Date: 2/25/2009 By: JC

This survey consists of:

Map: _____

Narrative: _____

Corner Rpt: 65/66-12

DOUGLAS COUNTY
SURVEYOR

OREGON CORNER RESTORATION FORM

Section 10 Township 30S Range 9W

County DOUGLAS Date 2-18-09

Corner Designation 1/4 corner Sec 10, E 11

500540
OLD RENEWAL 17^e 130

- Condition Report Only
- Not Found
- Renewed
- Unrecorded
- Surveyed In
- Referenced Out

Previous Renewals/Surveys, etc. 17^e 130

Monument(s) & Accessories Found: (Condition and Source)

1" I.P.

14" FIR SIDE 13^s GOOD-HEALED

29" FIR N15 1/2 W 86^s GOOD-HEALED - TREE WILL BE CUT TO MAKE ROOM FOR A ROAD

17" FIR N49W 19^l GOOD-HEALED

Monument Detail

Sketch

Monument Set (Procedures and Description)

New Accessories

RTs:

14" D. FIR NB1E 21^l SCRIBED "1/4 S BT"

18" D. FIR S4W 24^l SCRIBED "1/4 S BT"

Location & Comments

Surveyor's Seal

Compass Declination 14^o

Firm/Agency ROSEBURG

FOREST PRODUCTS


Address PO Box 1088

ROSEBURG OREGON 97470

Party Chief BILL OLSON

Notes _____

Witness _____

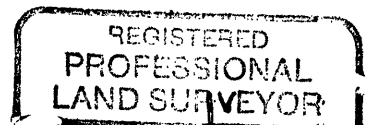

Mark F. Smalley

RENEWS 6/30/2010

C.S. File No 65/66-12