

OREGON CORNER RESTORATION FORM

FILED  
Date: 5/16/2009 By: JC  
This survey consists of:  
Map: \_\_\_\_\_  
Narrative: \_\_\_\_\_  
Corner Rpt: 65/66-17  
DOUGLAS COUNTY  
SURVEYOR

Section 20 Township 23 South, Range 6 West  
County Douglas Date 29 April 2009

Corner Description

Section Corner  
Sections 17, 18, 19, 20

- Condition Report Only
- Not Found
- Renewed
- Unrecorded
- Surveyed In
- Referenced Out

Previous Renewals / Surveys, etc.


Monument (s) & Accessories Found: (Condition and Source)

Found 3-1/4" BLM brass cap dated 1957 with the following accessories:

- 48" D. Fir bears S23-3/4°E 135.1' – healed face
- 30" D. Fir bears N48-3/4°E 30.3' – healed face
- 24" D. Fir bears S37-3/4°W 30.4' – healed face
- 30" D. Fir snag bears S41-1/2°W 13.3' – scribing visible
- 24" D. Fir snag bears N0-1/2°E 13.7' – healed face

Monument Detail

Sketch

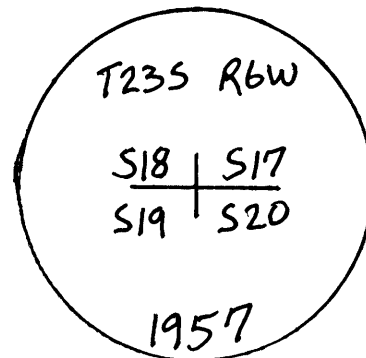

Monument Set (Procedures and Description)

None

New Accessories

None

Location & Comments

Corner has steel post \_\_\_\_\_ Compass Declination 17° East  
adjacent to it. \_\_\_\_\_ Firm/Agency Ward NorthWest Inc.  
All BT's have red painted  
bands and BT tags. \_\_\_\_\_ Address P.O. Box 105  
\_\_\_\_\_ Florence, OR 97439  
\_\_\_\_\_ Party Chief Ron Rice  
\_\_\_\_\_ Notes \_\_\_\_\_  
\_\_\_\_\_ Witness Josh Reed

Surveyor's Seal



RENEWS: 12-31-2010

C.S. File No 65/66-17