

OREGON CORNER RESTORATION FORM

Section 20 Township 23 South, Range 6 West
County Douglas Date 29 April 2009

FILED
Date: 5/6/2009 By: JC
This survey consists of:
Map: _____
Narrative: _____
Corner Rpt: 65/66-18
DOUGLAS COUNTY
SURVEYOR

Corner Description

N 1/16 Corner
Sections 19, 20

- Condition Report Only
- Not Found
- Renewed
- Unrecorded
- Surveyed In
- Referenced Out

Previous Renewals / Surveys, etc.

Monument (s) & Accessories Found: (Condition and Source)


Found 3-1/4" BLM brass cap dated 1994 with the following accessories:

32" D. Fir bears N79-1/4°E 46.9' – healed face

22" D. Fir bears N7-1/4°W 71.9' – healed face

Monument Detail

Sketch

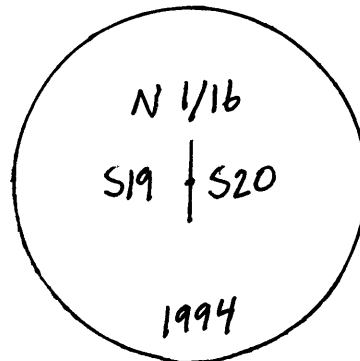

Monument Set (Procedures and Description)

None

New Accessories

None

Location & Comments

Corner has steel post _____ Compass Declination 17° East
adjacent to it. _____ Firm/Agency Ward NorthWest Inc.
All BT's have red painted _____
bands and BT tags. _____ Address P.O. Box 105
_____ Florence, OR 97439
_____ Party Chief Ron Rice
_____ Notes _____
_____ Witness Josh Reed

Surveyor's Seal



RENEWS: 12-31-2010

C.S. File No 65/66-18