

FILED

Date: 5/6/2009 By: JL

This survey consists of:

Map: _____

Narrative: _____

Corner Rpt: 65/66-19

DOUGLAS COUNTY
SURVEYOR

OREGON CORNER RESTORATION FORM

Section 20 Township 23 South, Range 6 West
County Douglas Date 29 April 2009

Corner Description

1/4 Corner
Sections 19, 20

- Condition Report Only
- Not Found
- Renewed
- Unrecorded
- Surveyed In
- Referenced Out

Previous Renewals / Surveys, etc.

Monument (s) & Accessories Found: (Condition and Source)

Found 3-1/4" BLM brass cap dated 1994 with the following accessories:

21" Hemlock bears N6°W 89.8' – healed face


18" D. Fir bears S60°E 31.0' – healed face

Monument Detail

Sketch

Monument Set (Procedures and Description)

None

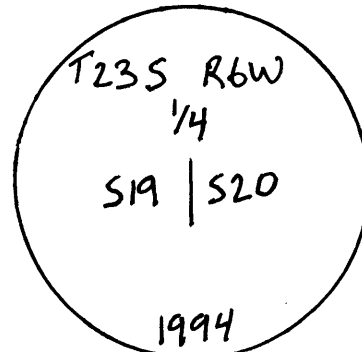

New Accessories

13" D. Fir bears S86°W 42.9' – blazed, scribed "1/4 S19 BT"

11" twin Alder bears N44°E 15.2' – scribed "1/4 S20 BT"

Location & Comments

Corner has steel post adjacent to it.

All BT's have red painted bands and BT tags.

Compass Declination 17° East
Firm/Agency Ward NorthWest Inc.

Address P.O. Box 105
Florence, OR 97439

Party Chief Ron Rice

Notes _____

Witness Josh Reed

Surveyor's Seal

REGISTERED
PROFESSIONAL
LAND SURVEYOR

Ronald L. Rice

OREGON
JULY 9, 2002
RONALD L. RICE
54633LS

RENEWS: 12-31-2010

C.S. File No 65/66-19