

FILED

Date: 5/6/09 By: JC

This survey consists of:

Map: _____

Native: _____

Corner Rpt: 65/66-20

DOUGLAS COUNTY
SURVEYOR

OREGON CORNER RESTORATION FORM

Section 20 Township 23 South, Range 6 West
County Douglas Date 29 April 2009

Corner Description

CN 1/16 Corner
Section 20

- Condition Report Only
- Not Found
- Renewed
- Unrecorded
- Surveyed In
- Referenced Out

Previous Renewals / Surveys, etc.

Monument (s) & Accessories Found: (Condition and Source)


Found 3-1/4" BLM brass cap dated 1994 with the following accessories:

14" Hemlock bears N74-1/2°E 21.5' – healed face

14" W. Red Cedar bears S60-1/4°W 38.3' – healed face

Monument Detail

Sketch

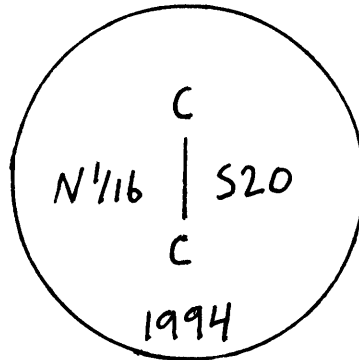

Monument Set (Procedures and Description)

None

New Accessories

None

Location & Comments

Corner has steel post adjacent to it.

All BT's have red painted bands and BT tags.

Compass Declination 17° East
Firm/Agency Ward NorthWest Inc.

Address P.O. Box 105
Florence, OR 97439

Party Chief Ron Rice

Notes _____

Witness Josh Reed

Surveyor's Seal



RENEWS: 12-31-2010

C.S. File No 65/66-20