

CORNER REPORT FORM

Section 31 Township 24S Range 3W
Douglas County Date: May, 2009

CORNER DESIGNATION:
NW 1/16


Previous Renewals/Surveys, etc:
Cadastral Survey - 1958, Page 12604

- Condition Report only
- Not Found
- Renewed
- Unrecorded
- Surveyed In
- Referenced out

Monument(s) & Accessories Found: (Condition and Source)

25" Hemlock N80 1/2 E 24.4' Healed face - Snag 1958
25" Fir W 21 lks - Gone 1958

Monument Detail Sketch:

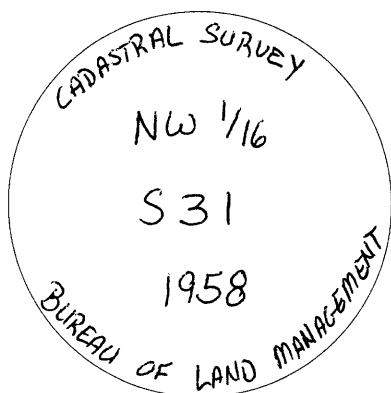

FILED
Date: 6/22/09 By: JC
This survey consists of:
Map: _____
Name(s): _____
Corner Rpt: 65/66-22

DOUGLAS COUNTY
SURVEYOR

Monument Set: (Procedures and Description)

New Accessories:

- 8" Douglas fir S60W 27.7' measured to a nail in the side-center of stump
Scribed "NW1/16BT" with LS 2354 brass washer
- 8" Douglas fir S3E 37.1' measured to a nail in the side-center of stump
Scribed "NW1/16BT" with LS 2354 brass washer

Location & Comments:

Compass Declination: 18°
Firm/Agency: Roseburg Forest Products
Address: PO Box 1088
Roseburg, OR 97470
Party Chief: William Olson
Notes:
Witness: Niel Danko

Surveyor's Seal

REGISTERED
PROFESSIONAL
LAND SURVEYOR

Mark F. Smalley

OREGON
July 26, 1988
MARK F. SMALLEY
2354

RENEWS: 6/10/2010

C.S. File No 65/66-22