

CORNER REPORT FORM

Section 31 Township 24S Range 3W  
Douglas County Date: May, 2009


CORNER DESIGNATION:  
CW 1/16

Previous Renewals/Surveys, etc:  
Cadastral Survey - 1958, Page 12601

___	Condition Report only
___	Not Found
<u>X</u>	Renewed
___	Unrecorded
___	Surveyed In
___	Referenced out

Monument(s) & Accessories Found: (Condition and Source)  
71" Douglas fir N 20 ¼ W 159.1' Healed face 1958  
35" Fir S57W 257.5 lks Gone 1958

Monument Detail Sketch:

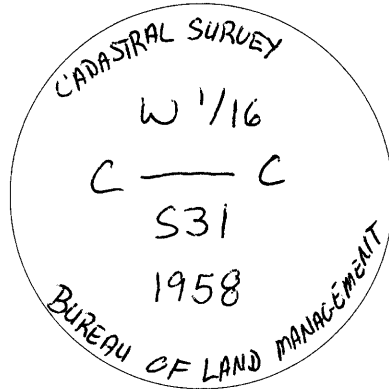

FILED  
Date: 6/22/2009 By: JC  
This survey consists of:  
Map: \_\_\_\_\_  
Narrative: \_\_\_\_\_  
Corner Rpt: 65/66-23

DOUGLAS COUNTY  
SURVEYOR

Monument Set: (Procedures and Description)

New Accessories:

12" Douglas fir N79E 47.8' measured to a nail in the side-center of stump  
Scribed "CW1/16BT" with LS 2354 brass washer

Location & Comments:

Compass Declination: 18°  
Firm/Agency: Roseburg Forest Products  
Address: PO Box 1088  
Roseburg, OR 97470  
Party Chief: William Olson  
Notes:  
Witness: Niel Danko

Surveyor's Seal

REGISTERED  
PROFESSIONAL  
LAND SURVEYOR

*Mark F. Smalley*

OREGON  
July 26, 1988  
MARK F. SMALLEY  
2354

RENEWS: 6/10/2010

C.S. File No 65/66-23