

**CORNER REPORT FORM**

Section 12 Township 24S Range 8W  
Douglas County **Date:** June, 2009

**CORNER DESIGNATION:** 600540  
N 1/4 11|12

- Condition Report only
- Not Found
- Renewed
- Unrecorded
- Surveyed In
- Referenced out


**Previous Renewals/Surveys, etc:**

GLO Survey - Chandler, 1893 Page 3323  
Cadastral Survey - Corbin, June 1959 Page 12612

**Monument(s) & Accessories Found: (Condition and Source)**

23" Fir S35E 27.3' healed face 1996 unrecorded RFP renewal  
19" Fir S78E 14.6' healed face 1996 unrecorded RFP renewal  
9" Fir S32W 36.5' healed face 1996 unrecorded RFP renewal  
18" Fir N63E 31.2' healed face 1996 unrecorded RFP renewal

**Monument Detail Sketch:**

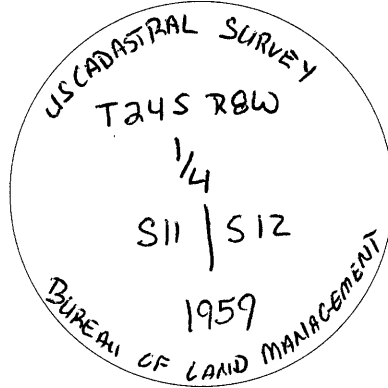

**Monument Set: (Procedures and Description)**

**New Accessories:**

**Location & Comments:**

Compass Declination: 18°  
Firm/Agency: Roseburg Forest Products  
Address: PO Box 1088  
Roseburg, OR 97470  
Party Chief: William Olson  
Notes:  
Witness: Niel Danko

Surveyor's Seal

REGISTERED  
PROFESSIONAL  
LAND SURVEYOR

*Mark F. Smalley*

OREGON  
July 26, 1988  
MARK F. SMALLEY  
2354

RENEWS: 6/10/2010

FILED

Date: 6/22/09 By: JC

This survey consists of:

Map: \_\_\_\_\_

Narrative: \_\_\_\_\_

Corner Not: 65/66-24

DOUGLAS COUNTY  
SURVEYOR

C.S. File No 65/66-24