

CORNER REPORT FORM

Section 12 Township 24S Range 8W
Douglas County Date: June, 2009
CORNER DESIGNATION: 600600
SEC COR 1,2,11,12

- Condition Report only
- Not Found
- Renewed
- Unrecorded
- Surveyed In
- Referenced out

Previous Renewals/Surveys, etc:

GLO Survey - Chandler, 1893 Page 3323
Cadastral Survey - Corbin, June 1959 Page 12612


Monument(s) & Accessories Found: (Condition and Source)

- Rotten Hemlock snag N42 1/4 E 16.5' Stump 1893
- 60" Fir S57E 29.7' Stump 1893
- 58" Fir S63W 11.2' Stump 1893
- 30" Hemlock N22W 38.3' Stump 1893
- 11" Hemlock S68 1/4 E 33.8 (rec 35.6') Healed face 1959
- 18" Hemlock N26 3/4 W 26.7' Healed face BLM 2005
- 12" Hemlock S25W 50.4' Partially healed face BLM 2005
- 7" Douglas fir N 52 1/4 E 23.5' Partially healed face BLM 2005
- 6" Hemlock N49 1/4 E 30.4' 1959 Gone
- 6" Hemlock S33 1/4 W 30.4' 1959 Gone
- 10" Hemlock N27W 26.4' 1959 Gone

FILED

Date: 6/22/2009 By: JC
 This survey consists of: _____
 Map: _____
 Narrative: _____
 Corner Rpt: 65/66-25
 DOUGLAS COUNTY
 SURVEYOR

Monument Detail Sketch:

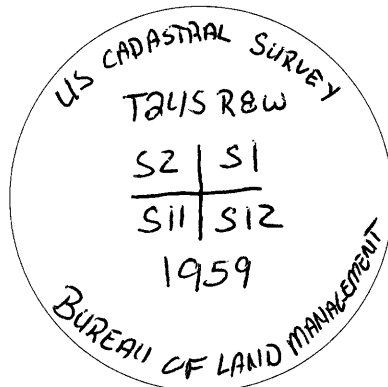

Monument Set: (Procedures and Description)

New Accessories:

Location & Comments:

Compass Declination: 18°
 Firm/Agency: Roseburg Forest Products
 Address: PO Box 1088
 Roseburg, OR 97470
 Party Chief: William Olson
 Notes:
 Witness: Niel Danko

Surveyor's Seal

REGISTERED
PROFESSIONAL
LAND SURVEYOR

Mark F. Smalley

OREGON
July 26, 1988
MARK F. SMALLEY
2354

RENEWS: 6/10/2010
C.S. File No 65/66-25