

CORNER REPORT FORM

Section 28 Township 28S Range 08W
Douglas County Date: May 2009
CORNER DESIGNATION: 340300
N1/4 Section 28

___ Condition Report only
___ Not Found
X Renewed
___ Unrecorded
___ Surveyed In
___ Referenced out

Previous Renewals/Surveys, etc:

BLM Resurvey June 1969/April 1973
Vol. 36 Page 15083-84
D. Bentz Aug, 1993, M117-61
Fd ok by D. Edwards Jan 2003, M141-66

FILED

Date: 6/22/09 By: JC

This survey consists of:

Map: _____

Narrative: _____


Corner Rpt: 65/66-27

Monument(s) & Accessories Found: (Condition and Source)

13" Fir S37 1/4 E 82 lks Rotten stump 1973
15" Fir N17W 43 lks Dead snag with healed face 1973

DOUGLAS COUNTY
SURVEYOR

Monument Detail Sketch:

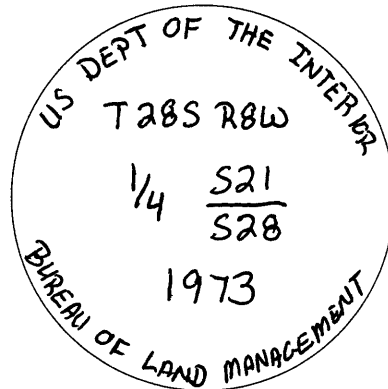

Monument Set: (Procedures and Description)

New Accessories:

15" Douglas fir N60E 25.6' measured to nail in the side-center of stump
Scribed "1/4SBT" with LS 2354 brass washer
13" White Fir S62W 22.9' measured to nail in the side-center of stump
Scribed "1/4SBT" with LS 2354 brass washer
18" Douglas fir S38E 45.4' measured to nail in the side-center of stump
Scribed "1/4SBT" with LS 2354 brass washer
11" White Fir S52E 13.2' measured to nail in the side-center of stump
Scribed "1/4SBT" with LS 2354 brass washer

Location & Comments:

Compass Declination: 18°
Firm/Agency: Roseburg Forest Products
Address: PO Box 1088
Roseburg, OR 97470
Party Chief: William Olson
Notes:
Witness: Niel Danko

Surveyor's Seal

REGISTERED
PROFESSIONAL
LAND SURVEYOR

Mark F. Smalley

OREGON
July 26, 1988
MARK F. SMALLEY
2354

C.S. File No 65/66-27

RENEWS: 6/10/2010