

CORNER REPORT FORM

Section 28 Township 28S Range 08W
Douglas County Date: May 2009

CORNER DESIGNATION

W1/16 Sec 21 / Sec 28

Previous Renewals/Surveys, etc:


BLM Resurvey April 1973 Page 15084
D. Edwards Jan 2003, M141-66

- Condition Report only
- Not Found
- Renewed
- Unrecorded
- Surveyed In
- Referenced out

Monument(s) & Accessories Found: (Condition and Source)

13" Fir S22E 12.5' Healed face 1973
24" Fir N68W 64.68' 1973 GONE

Monument Detail Sketch:

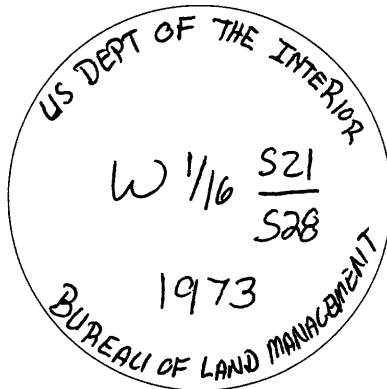

Monument Set: (Procedures and Description)

New Accessories:

18" Douglas fir N88E 26.0' measured to nail in the side-center of stump
Scribed "W1/16BT" with LS 2354 brass washer

Location & Comments:

Compass Declination: 18°
Firm/Agency: Roseburg Forest Products
Address: PO Box 1088
Roseburg, OR 97470
Party Chief: William Olson
Notes:
Witness: Niel Danko

Surveyor's Seal

REGISTERED
PROFESSIONAL
LAND SURVEYOR

Mark F. Smalley

OREGON
July 26, 1988
MARK F. SMALLEY
2354

RENEWS: 6/10/2010

FILED

Date: 6-22-2009 By: JC

This survey consists of: .

Map: _____

Narrative: _____

Corner Rpt: 65/66-29

**DOUGLAS COUNTY
SURVEYOR**

C.S. File No 65/66-29