

CORNER REPORT FORM

Section 8 Township 32S Range 4W
Douglas County Date: May, 2009
CORNER DESIGNATION: 300500
Section Corner Sec 8,9,16,17

- Condition Report only
- Not Found
- Renewed
- Unrecorded
- Surveyed In
- Referenced out

Previous Renewals/Surveys, etc:


GLO Survey, Nicklin, May 1896, Page(s) 8527-28
Wenderoth, April 1948
BLM Resurvey, Evans, May/June 1971 Page(s) 15347-48
C.S. 63/52 by Baughman Technical Services Inc.
DeGroot - Nov. 1990

FILED
Date: 6/22/2009 By: JC
This survey consists of:
Map: _____
Narrative: _____
Corner Rpt: 65/66-30

Monument(s) & Accessories Found: (Condition and Source)

39" Douglas fir N86E 87.2' Healed blaze 1896 (Rec N83E, 86.46')
45" Douglas fir S68E 47.0' Stump 1896
54" Douglas fir S56W 99.0' Stump 1896
10" Madrone N65W 21.5' (Rec N68W 21.78') Stump 1948
Monument Detail Sketch:

DOUGLAS COUNTY
SURVEYOR

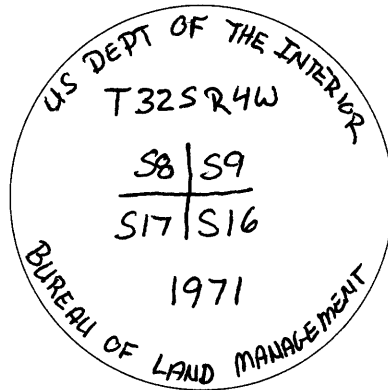

Monument Set: (Procedures and Description)

New Accessories:

11" Douglas fir N2W 12.9' measured to a nail in the side-center of stump
Scribed "S8BT" with LS 2354 brass washer
9" Douglas fir S81W 20.5' measured to a nail in the side-center of stump
Scribed "S17BT" with LS 2354 brass washer
5" Douglas fir S60E 15.2' measured to a nail in the side-center of stump
Scribed "S16BT" with LS 2354 brass washer

Location & Comments:

Compass Declination: 18°
Firm/Agency: Roseburg Forest Products
Address: PO Box 1088
Roseburg, OR 97470
Party Chief: William Olson
Notes:
Witness: Niel Danko

Surveyor's Seal



RENEWS: 6/10/2010

C.S. File No 65/66-30