

CORNER REPORT FORM

Section 8 Township 32S Range 4W
Douglas County **Date:** May, 2009


CORNER DESIGNATION:
SE 1/16

Previous Renewals/Surveys, etc:
C.S. 63/52 narrative survey, and M111-12 by
Baughman Technical Services Inc.
DeGroot - Nov. 1990

- Condition Report only
- Not Found
- Renewed
- Unrecorded
- Surveyed In
- Referenced out

Monument(s) & Accessories Found: (Condition and Source)
7" Madrone S64 1/2 E 7.5' Partial open face 1990
23" Douglas fir S38W 13.2' Healed face 1990

Monument Detail Sketch:

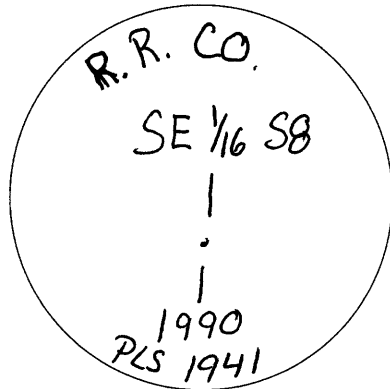

Monument Set: (Procedures and Description)

New Accessories:

Location & Comments:

Compass Declination: 18°
 Firm/Agency: Roseburg Forest Products
 Address: PO Box 1088
 Roseburg, OR 97470
 Party Chief: William Olson
 Notes:
 Witness: Niel Danko

Surveyor's Seal

REGISTERED
 PROFESSIONAL
 LAND SURVEYOR

Mark F. Smalley

OREGON
 July 26, 1988
 MARK F. SMALLEY
 2354

RENEWS: 6/10/2010

FILED

Date: 6/27/2009 By: JC
 This survey consists of: _____
 Map: _____
 Narrative: _____
 Corner Rpt: 65/66-31

DOUGLAS COUNTY
SURVEYOR

C.S. File No 65/66-31