

OREGON CORNER RESTORATION FORM

FILED

Section 12 Township 23 Range 4 W
 County Douglas Date 9/2/09

Date: 9/15/09 By: JC
 This survey consists of:
 Map: _____
 Narrative: _____
 Corner Rpt: CS 65/66-34

Corner Designation _____

DOUGLAS COUNTY
 SURVEYOR

SE 1/16 TH CORNER

- _____ Condition Report Only
- _____ Not Found
- X _____ Renewed
- _____ Unrecorded
- _____ Surveyed In
- _____ Referenced Out

Previous Renewals/Surveys, etc.

MAPS M26-80, M127-80, & CS 63/149-5


Monument(s) & Accessories Found: (Condition and Source)

14" Douglas Fir Bears N34°W 8.4 FT. as per record


Found a low cut 15" doug fir stump with a portion of a visible scar that could be old B.T. bears S35°W 4.0 ft.

record (S35°E 4.0 ft.) if the BT was at the record S35°E 4.0 feet it would have been removed by road construction

Monument Detail

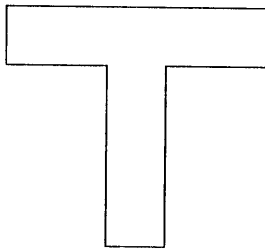

Sketch

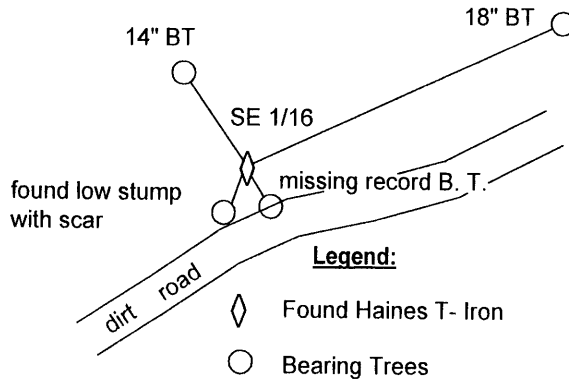

Monument Found

Found a Haines T -iron buried in logging slash with top cap missing.

New Accessories

18" Douglas Fir bears N76°E 41.8 ft. I scribe SE1/16 S12 B T and tag tree.

Location & Comments

Corner now lies on the cut bank of a new logging road, 4 ft. north of the top edge of the road cut bank.

Bearing Basis 16° declination
 Firm/Agency Lone Rock Timber Co.
 Address P. O. Box 1127
Roseburg, Ore. 97470
 Party Chief Ken W. Hoffine
 Notes Ken W. Hoffine
 Witness _____

REGISTERED
 PROFESSIONAL
 LAND SURVEYOR

Ken W. Hoffine

OREGON
 JULY 16, 1987
 KEN W. HOFFINE
 PLS 2291

EXPIRES 6-30-11

C.S. File No 65/66-34