

CORNER REPORT FORM

Section 26 Township 24S Range 2W
Douglas County Date: July 2009

CORNER DESIGNATION: 500200
SEC COR 26, 27, 34, & 35

Condition Report only
Not Found
 Renewed
Unrecorded
Surveyed In
Referenced out

Previous Renewals/Surveys, etc:

GLO Survey - Chandler, June 1893, Page 2902
BLM Resurvey - Tallett, May 1951 - White, Aug. 1963
Page 13293


Douglas County Surveyors Office - Smith, June 1992, C.S. File 64/26

Monument(s) & Accessories Found: (Condition and Source)

- 30" Hemlock snag, N 16 1/2 E, 21.6' (rec. N16 1/2 E, 19.8'), now a rotten 9' tall snag with scribe visible. 1893
- 20" Fir, S 31 1/4 E, 42.9', gone. 1893
- 28" Cedar snag, S 26 1/2 W, 19.2', now 12' tall rotten snag with scribe visible. 1893
- 26" Cedar snag, N 9 1/2 W, 16.8' (1951 GLO rec. N 9 1/2 W, 15.8'), 16' tall rotten snag. 1893
- 12" Hemlock, N 16 1/2 W, 33.3', uprooted and fallen down. 1992
- 12" Douglas fir, N 61 E, 31.6', healed face. 1992
- 7" Hemlock, S 58 1/2 E, 11.0', scribe visible. 1992
- 14" Hemlock, S 56 1/2 W, 48.4', healed face. 1992

FILED

Monument Detail Sketch:

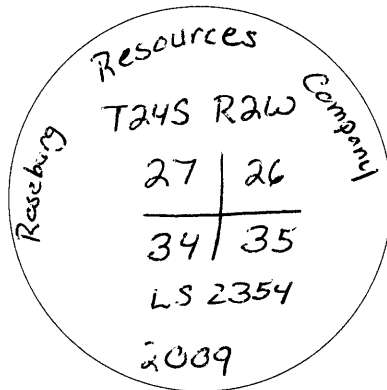

Case: 11-17-2009 By: JC
This survey consists of:
Map _____
Narrative: _____
Corner Rpt: 65/66-42

DOUGLAS COUNTY
SURVEYOR

Monument Set: (Procedures and Description)

Set 5/8" X 48" Rebar with Aluminum Cap. Pulled horizontal distances from bearing trees to set corner.

New Accessories:

8" Douglas fir, N 40 W, 6.4' measured to nail in side-center of stump.
Scribed "S27 BT" with LS 2354 brass washer.

Location & Comments:

Compass Declination: 18°
Firm/Agency: Roseburg Forest Products
Address: PO Box 1088
Roseburg, OR 97470
Party Chief: William Olson
Notes:
Witness: Niel Danko

Surveyor's Seal

REGISTERED
PROFESSIONAL
LAND SURVEYOR

Mark F. Smalley

OREGON
July 26, 1988
MARK F. SMALLEY
2354

RENEWS: 6/30/2010

C.S. File No 65/66-42