

CORNER REPORT FORM

Section 26 Township 24S Range 2W
Douglas County Date: June 2009

CORNER DESIGNATION: 540200
¼ cor. sec. 26/sec. 35

___ Condition Report only
___ Not Found
X Renewed
___ Unrecorded
___ Surveyed In
___ Referenced out

Previous Renewals/Surveys, etc:

GLO Survey, Chandler, June 1893, Page 2903
BLM dependent resurvey, Tallett, May 1951-Aug. 1963
Pages 13294


Douglas County Surveyors Office, Vernon Tracy, Aug 1969, C.S. 54/27

Monument(s) & Accessories Found: (Condition and Source)

27" fir, low cut stump, N42½E (Rec. N42°45'E), 67.3' 1951
47" fir, S14 ½ E, 64.7' 25' tall snag, 1951
9" Hemlock, N83W, 24.1', gone 1969

FILED
DATE: 11/17/2009 By: J
This survey consists of:
Map: _____
Name: _____
Corner Rpt: 65/66-43
DOUGLAS COUNTY
SURVEYOR

Monument Detail Sketch:

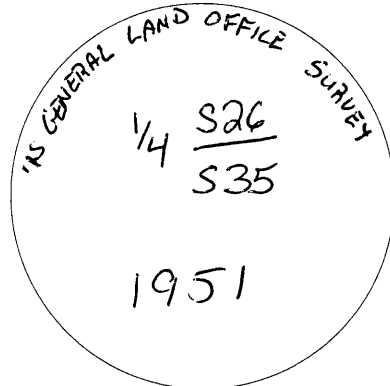

Monument Set: (Procedures and Description)

New Accessories:

8" Hemlock, N52E, 6.4' measured to nail in side center of stump, scribed "S1/4BT"
8" Douglas fir, N6E, 15.0' measured to nail in side center of stump, scribed "S1/4BT"
7" Douglas fir, N31W, 9.6' measured to nail in side center of stump, scribed "S1/4BT"
7" Hemlock, S52E, 31.1' measured to nail in side center of stump, scribed "S1/4BT"

Location & Comments:

Compass Declination: 18°
Firm/Agency: Roseburg Forest Products
Address: PO Box 1088
Roseburg, OR 97470
Party Chief: William Olson
Notes:
Witness: Niel Danko

Surveyor's Seal



RENEWS: 6/30/2010

C.S. File No 65/66-43