

CORNER REPORT FORM

Section 22 Township 25S Range 2W
Douglas County **Date:** 9/2009

CORNER DESIGNATION: 500340
¼ Cor. Secs. 22 & 23

- Condition Report only
- Not Found
- Renewed
- Unrecorded
- Surveyed In
- Referenced out


Previous Renewals/Surveys, etc:

GLO Survey, Johnson, May 1900, Page 3608.
Douglas Co. Survey Office, Byron, July 1958,
C.S. 49/102
McChesney, Wey Co., Aug 1958, C.S. 53/113
BLM resurvey, Skeesick, May 2001/June 2002, Pages 20921-2.

Monument(s) & Accessories Found: (Condition and Source)

- 51" Douglas fir, N50W, 21.2', with letters MC and axe marks visible in the bark, 1958 (Rec 52" dia)
- 13" Hemlock, N14½E, 19.5', partially healed face, 2002
- 10" Douglas fir, S70W, 29.1' partially healed face, 2002
- 60" Fir stump, S78½E, 39.2', 1958, rotten.
- 16" Decayed hemlock stump, S83¾W, 39.5', 1958, gone.
- A roothole, N34¾E, 15.8', 1900, Roothole not well defined.
- 14" Hemlock, S65W, 7.9', (Previous rec. as S55W, 7.9'), 1958, gone.

Monument Detail Sketch:

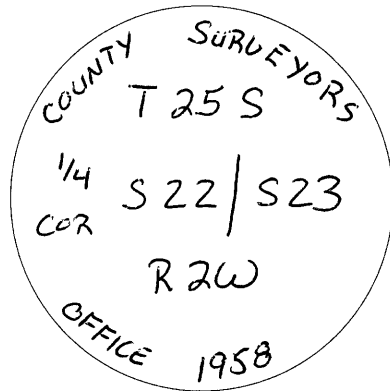

FILED
Date: 11/17/2009 **By:** _____
 This survey consists of: _____
Map: _____
Narrative: _____
Corner Ref: 65/66-44
DOUGLAS COUNTY SURVEYOR

Monument Set: (Procedures and Description)

New Accessories:

12" Douglas fir, S22E, 11.4' measured to a nail in the side-center of stump
Scribed "S23BT" with LS 2354 brass washer.

Location & Comments:

Compass Declination: 18°
Firm/Agency: Roseburg Forest Products
Address: PO Box 1088
Roseburg, OR 97470
Party Chief: William Olsen
Notes:
Witness: Niel Danko

Surveyor's Seal

REGISTERED
PROFESSIONAL
LAND SURVEYOR

Mark F. Smalley

OREGON
July 26, 1988
MARK F. SMALLEY
2354

C.S. File No 65/66-44

RENEWS: 6/30/2010