

CORNER REPORT FORM

Section 22 Township 25S Range 2W
Douglas County Date: 10/2009

CORNER DESIGNATION: 400400
Sec. Cor. 15, 16, 21, & 22

Condition Report only
Not Found
 Renewed
Unrecorded
Surveyed In
Referenced out


Previous Renewals/Surveys, etc:

GLO Survey, Johnson, May 1900, Page 3620.
Hosforf, Sept. 1957, C.S. 42/308
BLM resurvey, Brooks, April 1962, Pages 13226-7.
BLM resurvey, Skeesick, May 2001/June 2002, Pages 20927-8.

Monument(s) & Accessories Found: (Condition and Source)

26" Cedar, N43W, 14.5', healed blaze, 1957
20" Hemlock, S21W, 87.8', (rec. S20W), healed face, 1957
38" Cedar, S23 1/2 E, 57.4' healed face, 1962
A Decayed hemlock stump, size indeterminate, S41 1/4 E, 18.2', (rec. S45E, 17.2'), 1900.
A hemlock snag, 11", N28 3/4 E, 25.7', (Rec. N27E), 1957, Gone.
13" Hemlock, S78°30'W, 23.8', 1900, Gone.
14" Maple, N68W, 18.5', 1900, Gone.
7" Hemlock, N52E, 25.1', 1900, Gone.

Monument Detail Sketch:

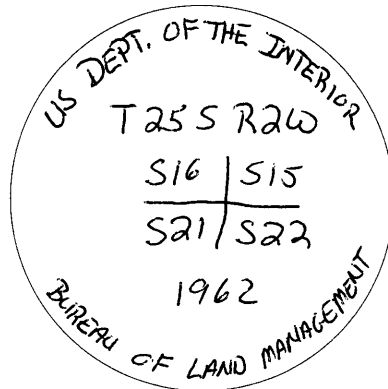

FILED
Date: 11/17/2009 By: JC
This survey consists of:
Map: _____
Narrative: _____
Corner Rpt: CS 65/66-45
DOUGLAS COUNTY
SURVEYOR

Monument Set: (Procedures and Description)

New Accessories: Set Oct. 1997 by Roseburg Forest Products, but not recorded.

17" Douglas fir, N12E, 12.4' measured to side center of root crown. Scribed "S15BT" but now healed face. 1997

Location & Comments:

Compass Declination: 18°
Firm/Agency: Roseburg Forest Products
Address: PO Box 1088
Roseburg, OR 97470
Party Chief: William Olson
Notes:
Witness: Niel Danko

Surveyor's Seal

REGISTERED
PROFESSIONAL
LAND SURVEYOR

Mark F. Smalley

OREGON
July 26, 1988
MARK F. SMALLEY
2354

RENEWS: 6/30/2010

C.S. File No CS/66-45