

**CORNER REPORT FORM**

Section 22 Township 25S Range 2W  
Douglas County **Date:** 9/2009

**CORNER DESIGNATION:** 400340  
¼ Cor. Secs. 21 & 22

\_\_\_\_ Condition Report only  
\_\_\_\_ Not Found  
X Renewed  
\_\_\_\_ Unrecorded  
\_\_\_\_ Surveyed In  
\_\_\_\_ Referenced out

**Previous Renewals/Surveys, etc:**

GLO Survey, Johnson, May 1900, Page 3619-20.  
Hosford, Oct. 1957, C.S. 42/308  
BLM resurvey, Brooks, April 1962, Page 13226.

**Monument(s) & Accessories Found: (Condition and Source)**

Found IPBC set firmly in ground. 1962  
Found deposited 1.5" X 36" iron pipe laying on top of ground. 1962.  
20" Douglas fir, N23W, 20.8', Healed Face, 1957.  
Rotten fir stump, N88E, 5.0', 1957.

**Monument Detail Sketch:**



**FILED**

**Date:** 11/17/2009 **By:** J

This survey consists of:

**Map:** \_\_\_\_\_

**Narrative:** \_\_\_\_\_

**Corner Rpt:** CS 65/66-46

**DOUGLAS COUNTY  
SURVEYOR**

**Monument Set: (Procedures and Description)**


**New Accessories:** Set by Roseburg Resources in Oct. 1997.

15" Cedar, N63E, 28.7', Healed Face, 1997.  
11" Madrone, S75W, 10.2', Healed Face, 1997.  
23" Douglas fir, N45W, 34.7', Partially Healed Face, 1997.


**Location & Comments:**

Compass Declination: 18°  
Firm/Agency: Roseburg Forest Products  
Address: PO Box 1088  
Roseburg, OR 97470  
Party Chief: William Olson  
Notes:  
Witness: Ken Coble

Surveyor's Seal

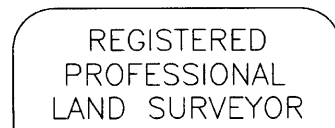

*Mark F. Smalley*

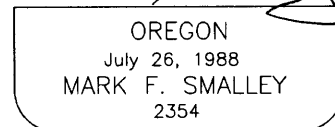

RENEWS: 6/30/2010

**C.S. File No** 65/66-46