

CORNER REPORT FORM

Section 19 Township 29S Range 7W
Douglas County **Date:** June 2009

CORNER DESIGNATION:

South 1/16 Sec 19 West Line

Previous Renewals/Surveys, etc:


BLM Resurvey, 1988, Page 18530

- Condition Report only
- Not Found
- Renewed
- Unrecorded
- Surveyed In
- Referenced out

Monument(s) & Accessories Found: (Condition and Source)

22" White Fir N82W 16.5' healed face 1988
15" Douglas fir S85 3/4 E 43.6' healed face 1988

Monument Detail Sketch:

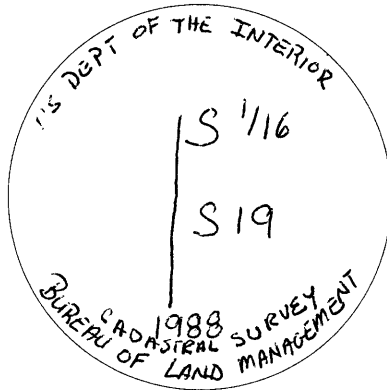

Monument Set: (Procedures and Description)

New Accessories:

Location & Comments:

Compass Declination: 18°
Firm/Agency: Roseburg Forest Products
Address: PO Box 1088
Roseburg, OR 97470
Party Chief: William Olson
Notes:
Witness: Ken Coble

FILED

Date: 11/17/2009 By: JC

This survey consists of: _____

Map: _____

Narrative: _____

Corner Rpt: CS 65/66-47

**DOUGLAS COUNTY
SURVEYOR**

Surveyor's Seal

REGISTERED
PROFESSIONAL
LAND SURVEYOR

Mark F. Smalley

OREGON
July 26, 1988
MARK F. SMALLEY
2354

RENEWS: 6/30/2010

C.S. File No 65/66-47