

CORNER REPORT FORM

Section 19 Township 29S Range 7W
Douglas County **Date:** June 2009

CORNER DESIGNATION: 100340
W 1/4 cor. of sec. 19 only, T29-7


___ Condition Report only
___ Not Found
X Renewed
___ Unrecorded
___ Surveyed In
___ Referenced out

Previous Renewals/Surveys, etc:
Mensch. Corrective resurvey, 1924, Page 6014
Byron, July 1962, C.S. 49/139
BLM Resurvey, June 1988/Feb. 1989, Page 18530

Monument(s) & Accessories Found: (Condition and Source)

30" Laurel S39E 51.5' healed face 1924
14" Laurel East 7.5' in poor condition with partially healed face. 1962
10" Cedar N31E 43 lks 1924 Gone

Monument Detail Sketch:

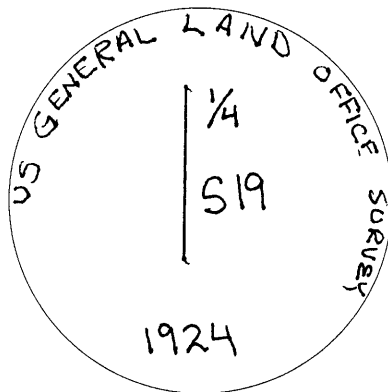

FILED
Date: 11/17/2009 **By:** JC
This survey consists of: _____
Map: _____
Narrative: _____
Corner Rpt: CS 65/66-48
DOUGLAS COUNTY
SURVEYOR

DUPLICATE OF C.S. 65/66-48

Monument Set: (Procedures and Description)

New Accessories:

6" Douglas fir, N8E, 42.2' measured to nail in side center of stump, Scribed "1/4S19BT"
14" Douglas fir, S50E, 31.1' measured to nail in side center of stump, Scribed "1/4S19BT"

Location & Comments:

Compass Declination: 18°
Firm/Agency: Roseburg Forest Products
Address: PO Box 1088
Roseburg, OR 97470
Party Chief: William Olson
Notes:
Witness: Ken Coble

Surveyor's Seal

REGISTERED
PROFESSIONAL
LAND SURVEYOR

Mark F. Smalley

OREGON
July 26, 1988
MARK F. SMALLEY
2354

RENEWS: 6/30/2010

C.S. File No 65/66-48