

CORNER REPORT FORM

Section 24 Township 29S Range 8W
Douglas County **Date:** June 2009

CORNER DESIGNATION: 700400
Sec. cor. to 13 & 24 only, East

- Condition Report only
- Not Found
- Renewed
- Unrecorded
- Surveyed In
- Referenced out


Previous Renewals/Surveys, etc:

Hathorn, April 1855, Page 6570
Mensch, April 1924, Pages 6013-14
Byron, July 1962, C.S. 49/139
Monrean, Feb. 1977, C.S. 59/29
Smalley, April 2003, C.S. 65/45-30

Monument(s) & Accessories Found: (Condition and Source)

27" Fir N28W 13.9' healed face and "X" scribed on tree 1855
16" White Fir North, 1.5', healed face 1962
32" White Fir S1W, 61.6', healed face 1962
15" White Fir S2W, 15.9', partially healed face, scribe partially visible 2003
21" Hemlock N50W, 43.0', healed face 2003
10" Fir N20E 14 lks 1855 Gone
30" Fir S75E 36 lks 1855 Gone
10" Dogwood N6W 34 lks ~~1855~~ 1924 Gone
14" Fir S27W 31 lks 1924 Rotting root was found

Monument Detail Sketch:

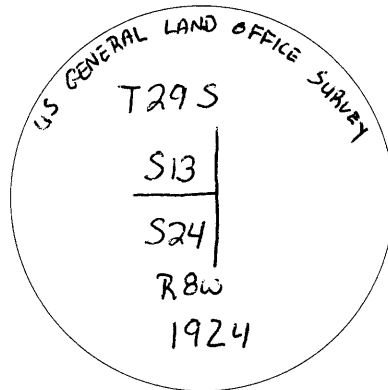

FILED

Date: 11/17/2009 By: JC
 This survey consists of:
 Map: _____
 Narrative: _____
 Corner Rpt: CS 65/66-49

**DOUGLAS COUNTY
SURVEYOR**

Monument Set: (Procedures and Description)

New Accessories:

Location & Comments:

Compass Declination: 18°
Firm/Agency: Roseburg Forest Products
Address: PO Box 1088
Roseburg, OR 97470
Party Chief: William Olson
Notes:
Witness: Niel Danko

Surveyor's Seal

REGISTERED
PROFESSIONAL
LAND SURVEYOR

Mark F. Smalley

OREGON
July 26, 1988
MARK F. SMALLEY
2354

RENEWS: 6/30/2010

C.S. File No 65/66-49