

CORNER REPORT FORM

Section 19 Township 29S Range 8W
Douglas County Date: June 2009

CORNER DESIGNATION: 100371

West 1/4 of Sec 19 only, T29-7


Previous Renewals/Surveys, etc:

Mensch, April 1924, Page 6014
Byron, July 1962, C.S. 49/139
BLM Resurvey, June 1988/Feb.1989, Page 18530

Monument(s) & Accessories Found: (Condition and Source)

30" Laurel S39E 51.5' healed face 1924
14" Laurel EAST 7.5' partially healed face 1962
10" Cedar N31E 43 lks 1924 GONE

Monument Detail Sketch:

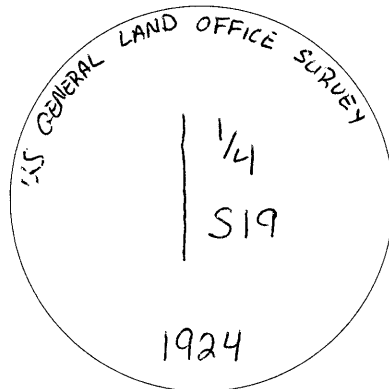

Monument Set: (Procedures and Description)

New Accessories:

6" Douglas fir, N8E, 42.2' measured to nail in side center of stump
Scribed "1/4S19BT"
14" Douglas fir, S50E, 31.1' measured to nail in side center of stump
Scribed "1/4S19BT"

Location & Comments:

Compass Declination: 18°
Firm/Agency: Roseburg Forest Products
Address: PO Box 1088
Roseburg, OR 97470
Party Chief: William Olson
Notes:
Witness: Ken Coble

Surveyor's Seal

REGISTERED
PROFESSIONAL
LAND SURVEYOR

Mark F. Smalley

OREGON
July 26, 1988
MARK F. SMALLEY
2354

RENEWS: 6/30/2010

Condition Report only
Not Found
 Renewed
Unrecorded
Surveyed In
Referenced out

FILED
Date: 11/17/2009 By: J
This survey consists of:
Map: _____
Narrative: _____
Corner Rpt: CS 65/66-50

DOUGLAS COUNTY
SURVEYOR

DUPLICATE OF C.S. 65/66-48

C.S. File No 65/66-50