

CORNER REPORT FORM

Section 10 Township 30S Range 5W  
Douglas County Date: July 2009  
CORNER DESIGNATION: E1/16 Sec 10 / 15

- Condition Report only
- Not Found
- Renewed
- Unrecorded
- Surveyed In
- Referenced out


Previous Renewals/Surveys, etc:

BLM Resurvey - Roseberry & Jelley -  
Oct. 1967/June 1969, Pages 15539-15540  
Roseburg Resources Co., Johnstone, Nov. 1986, M103-1  
BLM Resurvey - Rogers, Aug 1990/July 1991, Page 19111

Monument(s) & Accessories Found: (Condition and Source)

23" Douglas fir, S 21 W, 40.3', healed face. 1969  
20" Fir snag, N 69 W, 61.4', rotten and laying on ground and was moved in road construction from original location. 1969  
11" Fir, N 7 E, 35.0', gone, was removed during road construction. 1990/1991

Monument Detail Sketch:

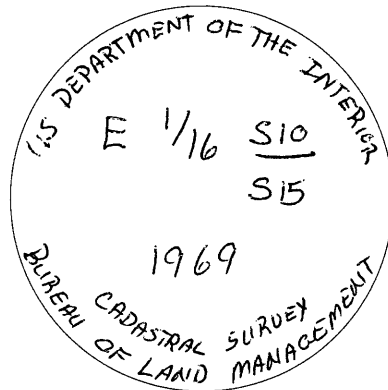

FILED  
Date: 11/17/2009 By: JC  
This survey consists of:  
Map: \_\_\_\_\_  
Narrative: \_\_\_\_\_  
Corner Rpts: CS 65/66-51  
**DOUGLAS COUNTY SURVEYOR**

Monument Set: (Procedures and Description)

New Accessories:

8" Douglas fir, N 84 E, 17.3' measured to nail in side-center of stump.  
Scribed "E1/16BT" with LS 2354 brass washer

Location & Comments:

Compass Declination: 18°  
Firm/Agency: Roseburg Forest Products  
Address: PO Box 1088  
Roseburg, OR 97470  
Party Chief: William Olson  
Notes:  
Witness: Niel Danko

Surveyor's Seal

REGISTERED  
PROFESSIONAL  
LAND SURVEYOR

*Mark F. Smalley*

OREGON  
July 26, 1988  
MARK F. SMALLEY  
2354

RENEWS: 6/30/2010

**C.S. File No 65/66-51**