

CORNER REPORT FORM

Section 08 Township 32S Range 04W
Douglas County **Date:** 8/2009
CORNER DESIGNATION: CE 1/16

___ Condition Report only
___ Not Found
X Renewed
___ Unrecorded
___ Surveyed In
___ Referenced out


Previous Renewals/Surveys, etc:
C.S. 63/52 narrative survey, and M111-12 by
Baughman Technical Services Inc.
DeGroot - Nov. 1990

Monument(s) & Accessories Found: (Condition and Source)

10" Hemlock, N 38 1/2 E, 25.5', 1990, Stump
6" Hemlock, N 60 W, 14.6', 1990, Stump

FILED
Date: 11/17/2009 By: JC
This survey consists of:
Map: _____
Narrative: _____
Corner Rpt: CS 65/66-52

Monument Detail Sketch:

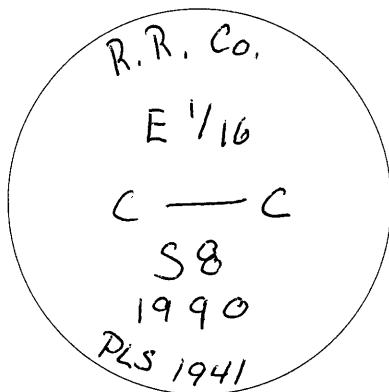

**DOUGLAS COUNTY
SURVEYOR**

Monument Set: (Procedures and Description)

New Accessories:

11" Hemlock, S 25 E, 11.8' measured to a nail in the side-center of stump
Scribed "CE1/16BT" with LS 2354 brass washer
10" Hemlock, S 65 E, 14.5' measured to a nail in the side-center of stump
Scribed "CE1/16BT" with LS 2354 brass washer

Location & Comments:

Compass Declination: 18°
Firm/Agency: Roseburg Forest Products
Address: PO Box 1088
Roseburg, OR 97470
Party Chief: W. Olson
Notes:
Witness: N. Danko

Surveyor's Seal

REGISTERED
PROFESSIONAL
LAND SURVEYOR

Mark F. Smalley

OREGON
July 26, 1988
MARK F. SMALLEY
2354

RENEWS: 6/30/2010

C.S. File No 65/66-52