

FILED

Date: 11/30/2009 By: JC

This survey consists of:

Map: _____

Narrative: _____

Corner Rpt: CS 65/66-54

CORNER REPORT FORM

Section 6 Township 30S Range 1W

Douglas County Date 11-25-09

CORNER DESIGNATION

200-640
1/4 56/55

DOUGLAS COUNTY
Condition RENEWED
Not Found
Renewed
Unrecorded
Surveyed In
Referenced out

Previous Renewals/Surveys, etc:

M 117-62 M 79-73
M 58-56

Monument(s) & Accessories Found: (Condition and Source)

FD ORIG. CORNER STUMP WITH SPIKE
FD DCSD TERRASS CAP (RENEWAL #31-194-213)
12" FIR S82W 22.4 FT
11" CEDAR N42W 10.1 FT (R.F.P 10/93 TAG)

21" FIR S63E 30' FT
20" FIR S89E 44'

Monument Detail

Sketch



Monument Set (Procedures and Description)

NONE

New Accessories

NONE

Location & Comments

Surveyor's Seal

Compass Declination


Firm/Agency: i.e. Engineering, Inc.

Address: 809 SE Pine St.
Roseburg, OR 97470

Party Chief: RYAN PALMER *[Signature]*

Notes:

Witness: J. LEONARD

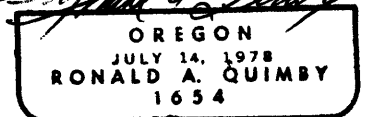

C.S. File No 65/66-54

EXP 12-31-10