

CORNER REPORT FORM

Section 16 Township 25 Range 2W
Douglas County Date Dec. 9, 2009

CORNER DESIGNATION

NW Section Corner

- Condition Report only
- Not Found
- Renewed
- Unrecorded
- Surveyed In
- Referenced out

Previous Renewals/Surveys, etc:


G.L.O. original survey in 1900. Private renewal in 1959 (C.S. File 53/112)
1962 B.L.M. Remonumentation.

Monument(s) & Accessories Found: (Condition and Source)

1962 B.L.M. Brass Cap.
Orig. B.T. : 36" diam. Fir bears N.37°E., 35.0 feet. Orig. Hemlock is a windfall.
Orig. Fir to SW is a stump. Orig. Dogwood is gone.
1962 B.T., a 38" diam. Fir bears S.14 1/2°E., 27.1 feet with healed blaze.
1962 Cedar B.T. to NW is a windfall.
Did not look for X BO in rock outcrop.

Monument Detail

Sketch

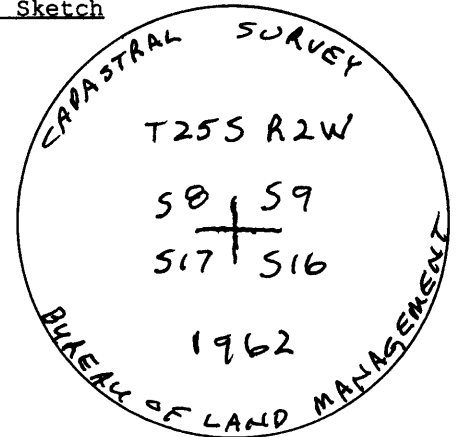

Monument Set (Procedures and Description)

N/A


New Accessories

A 6" diam. Cedar scribed "T25S R2W S8 BT" bears N.50°W., 32.5 feet.
A 6 foot steel post is set 2' East.

Location & Comments

Surveyor's Seal

Compass Declination 17°
Firm/Agency:
David Edwards Land Surveying
Address:
P.O. Box 361
Oakland, Oregon 97462
Party Chief:
Notes: BM
Witness:

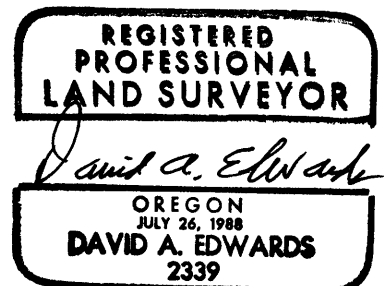

Renews 12/31/09

FILED
Date: 12/11/2009 By: JC
This survey consists of: _____
Map: _____
Narrative: _____
Corner Rpt: CS 65/66-56

DOUGLAS COUNTY
SURVEYOR

C.S. File No 65/66-56