

MAP OF SURVEY

LOCATED in the SE 1/4 of Sec. 2,
T. 28 S., R. 4 W., W.M. in
Douglas County, Oregon.

March 9, 2010

SURVEYED FOR: *SENECA JONES TIMBER CO.*
P.O. BOX 2129
ROSEBURG, OREGON 97470

SURVEYED BY: *DAVID EDWARDS LAND SURVEYING*
P.O. BOX 361
OAKLAND, OREGON 97462
PHONE: (541)459-0512

REGISTERED
PROFESSIONAL
LAND SURVEYOR

David A. Edwards

OREGON
JULY 26, 1908
DAVID A. EDWARDS
2339
RENEWS 12/31/11

LEGEND

- ⊙ INDICATES MONUMENT FOUND AS DESCRIBED ON M 138-8.
- INDICATES 5/8" DIAM. STEEL PIN W/CAP FOUND AS PER M 138-8
- INDICATES BOUNDARY BLAZED AND POSTED THIS SURVEY.

SCALE: 1" = 1000'

BASIS OF BEARINGS: EXISTING CONTROL PER M 138-8.


NARRATIVE

THE PURPOSE OF THIS SURVEY IS TO MARK THE EAST AND SOUTH LINES OF THE SE 1/4 OF SECTION 2. TRAVERSES WERE RUN BETWEEN EXISTING MONUMENTS AND OFFSETS MADE TO TRUE LINE. THE SUBJECT BOUNDARIES WERE MARKED BY BLAZING TREES ON EACH SIDE OF LINE, BY SETTING 6 FOOT STEEL POSTS ALONG THE LINE AT INTERVALS OF 200' OR LESS AND BY HANGING LIBERAL AMOUNTS OF RED FLAGGING ALONG THE TRUE LINE.

FIELD CREW: BRANT MILLER AND ERIC SPRINKLE.

EQUIPMENT: NIKON TOTAL STATION.

COMPUTATIONS AND DRAFTING: DAVID EDWARDS.

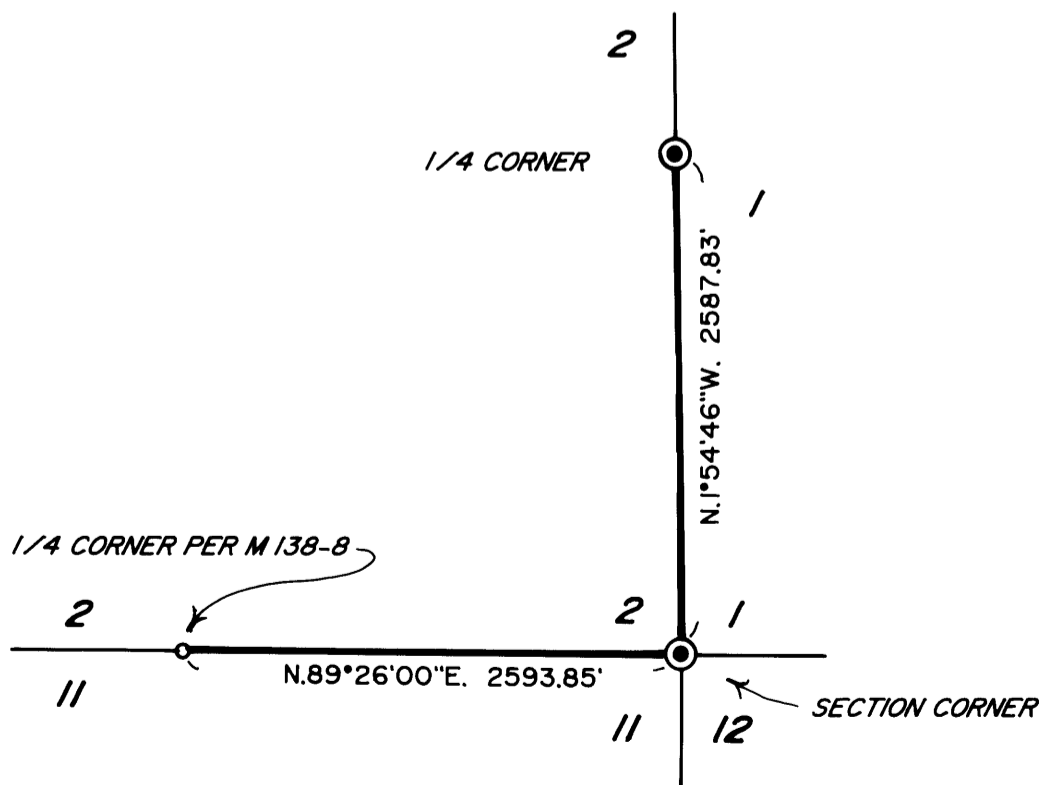

C.S. File No 65/69-2