

FILED

Date: 4-21-2010 By: JC

This survey consists of:

Map: _____
Narrative: _____
Order Rpt: CS 65/69-10

DOUGLAS COUNTY
SURVEYOR

CORNER NOTES

MARCH 2009

BY: TONY HOSTETTER
63538 PINTAIL DR.
COOS BAY, OR 97420

FOR: WEYERHAEUSER COMPANY
98674 DELLWOOD LANE
COOS BAY, OR 97420

1/4 CORNER, SECTION 33, T.24 S., R.9 W., W.M.
DOUGLAS COUNTY, OREGON

FOUND: 3/4" IRON PIPE (1971 WEYERHAEUSER RECORDS INDICATE THAT 2 ORIGINAL GLO BTS WERE FOUND, A 3/4" IRON PIPE WAS SET AT THAT TIME.)

FROM WHICH:

18" FIR STUMP, OBT, SCRIBING VISIBLE, WEYCO TAG & "W" NAIL,
BEARS: N 27°E, 5.3 FT TO CENTER.
(GLO: 18" FIR, N 27°E, 8 LKS)

24" FIR STUMP, OBT, SCRIBING VISIBLE, WEYCO TAG & "W" NAIL,
BEARS: S 40°W, 2.6 FT TO CENTER.
(GLO: 16" FIR, N 40°W, 4 LKS)

24" FIR STUMP, WEYCO TAG & "W" NAIL,
BEARS: N 49 1/2°E, 12.5 FT TO "W" NAIL.


NEW BTS:

15" FIR, WEYCO TAG & SPIKE,
BEARS: N 35°E, 18.2 FEET TO SPIKE.

14" FIR, WEYCO TAG & SPIKE,
BEARS: S 12°E, 23.3 FEET TO SPIKE.

15" FIR, WEYCO TAG & SPIKE,
BEARS: S 52°W, 31.6 FT TO SPIKE.

CORNER LOCATION: (GARMIN 60 CSX GPS)
43°25'54.1" N
123°46'7.9" W

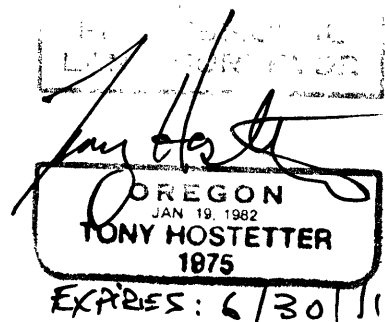

SQU-33-24-9.DOC

C.S. File No 65/69-10